


Section 25 Township 3 Range 24W

Well No. #1 Cora Fought

Company Woodriver Oil & Royalty

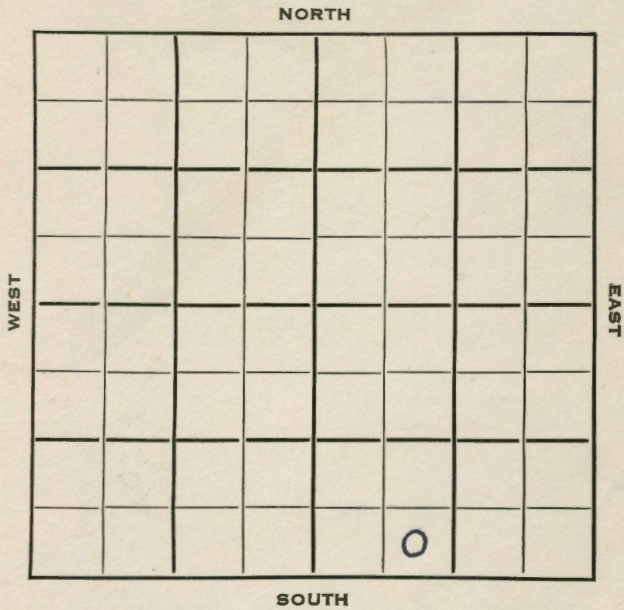

15

SEC. 25 TWP. 3 R. 24 W ✓  
 WELL NO. # 1 Cora Fought  
 COMPANY Woodriver Oil & Royalty


CONTRACTOR Empire Drlg. Wildcat  
 \_\_\_\_\_ Ft. from N. Line

330 \_\_\_\_\_ Ft. from S. Line

\_\_\_\_\_ Ft. from E. Line

990 \_\_\_\_\_ Ft. from W. Line

SE SW SE

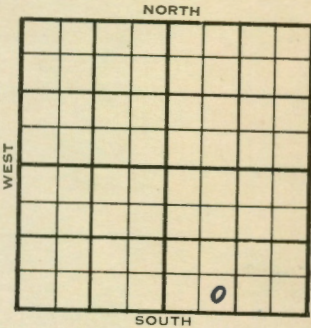

	ELEVATION	REPORT
1953	2438'	
10/7	MIR	
10/14	8" @ 283 Anhy 2025' Drlg. 3109'	
10/21	KC 3504, Arb. 3753 RTD 3754 5" @ 3753' DP 3756'	
10/28	NR	
11/4	NR	
11/11	S/6 BOPH POP	
11/18	NR	
12/16	NR	
1954		
1/20	Spud 10-9-53 Oil well TD 3756 8" @ 283 Anhy 2025 KC 3504 Arb. 3753 TD 3754 5" @ 3753 DD 3756 S/6 BOPH P/86 BOPD Comp. 115 BOPD	

COMPLETED

