


Section 25 Township 3 Range 24W

Well No. #4 Fought

Company Woodriver Oil & Ref.

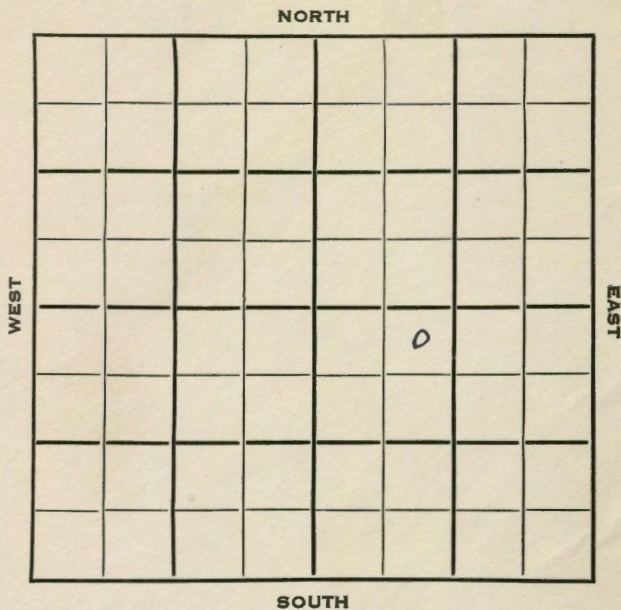

10

SEC. 25 TWP. 3 R. 24W **KANSAS**

WELL NO. #4 Fought FARM

COMPANY Woodriver Oil & Ref.

CONTRACTOR Empire Drlg.

Norton

330 _____ Ft. from N. Line

_____ Ft. from S. Line

_____ Ft. from E. Line

990 _____ Ft. from W. Line

NE NW SE

	ELEVATION	REPORT
1954	2402'	
3/2	Spud 2-24-54 8" @ 275'	Anhy 2010' Drlg 3150'
3/10	Heeb 3438' Tor 3463 Lans 3482 Reagan 3725 Cored 3728-48 RTD 3748 5" @ 3748	
3/17	All Tops, TD & Pipe Corrected: 6' up hole. CO 3742' 24/3721-29 1/2 wtr Sq CO 16/3721-25 VSSO	
3/24	NR	
3/31	Oil-frac.	
4/21	Spud 2-24-54 Oil Well TD 3742' 8" @ 275'	Anhy 2010'; Heeb 3432', Tor 3457', Lans 3476', Reagan 3719' TD 3742' 5" @ 3742' CO to 3742, 24/3721-29 wtr. 16/3721-25, VSSO Oil-frac Comp. 80 bopd

COMPLETED

