


SECTION 25 TOWNSHIP 3S RANGE 24W
WELL NO. #7 Fought
COMPANY Woodriver Oil & Gas

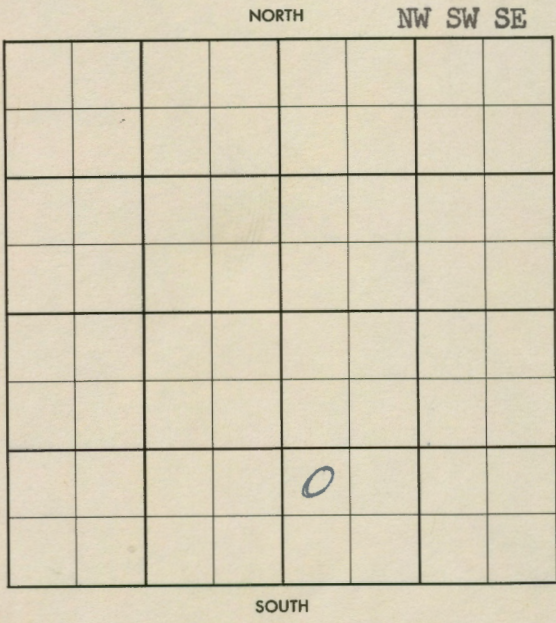

FORM 513 SUNRAY

County Norton Elev. _____
Sec. 25 Twp. 3S Rgn. 24W
Company Woodriver Oil & Gas
Farm Name Fought No. 7

TOPS	DEPTH	LOG	DATUM	Loc. in Sec.
Anh.				NW SW SE
TP.				
H.				
Tr.				
Dg.				
Bl.				
L.				Geol.
K.C.				Contr.
B.K.C.				K&E Tools
Ce.				Pool
C.				Norton
M.				
M.				
K.				
Mz.				
Me.				
V.				
S.				
S.				
A.				
R.				
Pe.				
G.				
TD				

FIRST REPORT
SEP 4 '57
0

Date Comm. _____
Location _____

BOPH NW 50' 0 BOT 1 24 hrs
 test OCT 9 '57 380 PATTW
 P.P.P.
 P 30 BOPD ~~WOL~~ OCT 16 '57
 OCT 23 '57

P 30 BOPD + NW 2 + 2

Regan 3773-75

25-3-24W

nw sw se

County ~~Norton~~ Elev. Est. 2458 OF
 Sec. ~~25~~ Twp. 3S Rge. 24W
 Company Woodriver Oil & Gas
 Farm Name Fought No. 7

TOPS	DEPTH	LOG	DATUM	Loc. in Sec.
Anb.				NW SW SE
Tr.				
H.	3482			
Tr.				
Dg.				
Bl.				
L.	3520			
K.C. Regan	3774			Geol.
B.K.C.				Contr.
Ce.				K&E Tools
C.				
M.				Pool
M.				Norton
K.				
Mz.				
Ma.				
V.				
S.				
S.				
A.				
R.				
PE.				
G.				
T.D.	3778			

COMPLETE
 OCT 23 '57
 OCT 20

Date Comm.

Location SEP 11 '57 M + R SEP 18 '57
 9-11 484 260 ϕ 3400
 SEP 25 '57 DST 3520-60 1hr 45' mdy
 W BHP 110/20" DST 3580-3600
 1hr 20' m 134 1045/20" DST
 3773-78 1hr 40' GIP 350' oil
 134 260/20" 5" 3773 WOC
 OCT 2 '57 CO 3775 250 acid 536
 BOPH NW 9 hrs \$100