


Norton

KANSAS

Section 35 Township 3 Range 24 WWell No. # 2 HenryCompany Harry Gore

NORTH

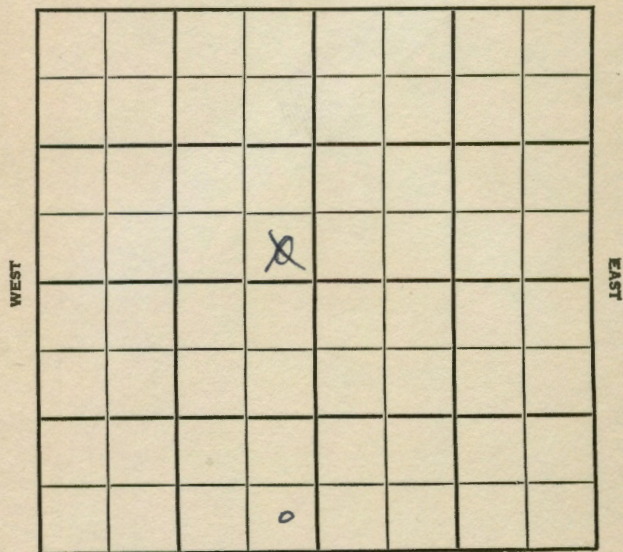

SOUTH

6

SEC.

35

TWP.

3

R.

24W

WELL NO.

#2 Henry

COMPANY

FARM

Harry Gore

CONTRACTOR

Co. Tools.

Norton Pool

Ft. from N. Line

330

Ft. from S. Line


330

Ft. from E. Line

Ft. from W. Line

SE SE ~~NW~~ SW

NORTH

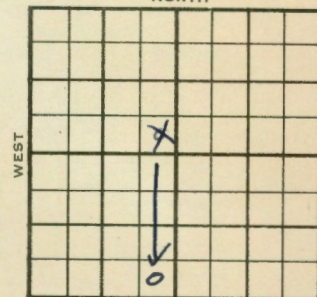

SOUTH

1954

ELEVATION

2497'

REPORT

9/15

8" @ 297'

WOC.

10/13

Spud 9-13-54

Oil Well

TD 3723'

8" @ 297'

Heeb 3420', Tor 3446 Lans 3460',
Arb 3719'

5" @ 3721'

TD 3723'

CO to 3723'

P/ 193 BO 18 hr.

Comp 193 bopd.

COMPLETED

FABEN GILSTRAP

FABEN GILSTRAP

Kansas

Map No. _____ Sec. 35 Twp. 3 R. 24W

Well No. 2 Henry

Harry Gore Company

CORRECTION Contractor

SE SE SW

SECTION PLAT

Ft. from N. Line

330 Ft. from S. Line

330 Ft. from E. Line

Ft. from W. Line

Norton County

Location

Rig up

Drilling and Remarks:

Reported
SE SE NW

RECORD

Cased in, ft.

Sand

Gas

Oil

Total Depth

PRODUCTION

1st 24 hrs. Nat.

1st 24 hrs. after shot

Gas Cu. Ft.

Dry Hole

Abandoned

Date

OCT 6 1954

FABEN GILSTRAP Scout