

Norton


KANSAS

SECTION 35 TOWNSHIP 3S RANGE 24W

WELL NO. #2 Henry

COMPANY R.P. Nixon

NORTH NE NE SW

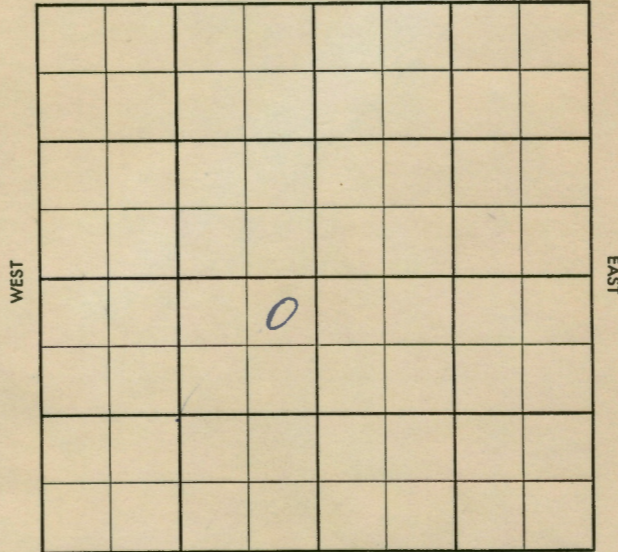

SOUTH

||

