


Section 32 Township 3 Range 24W

Well No. 1 Brunson

Company Harry Gore

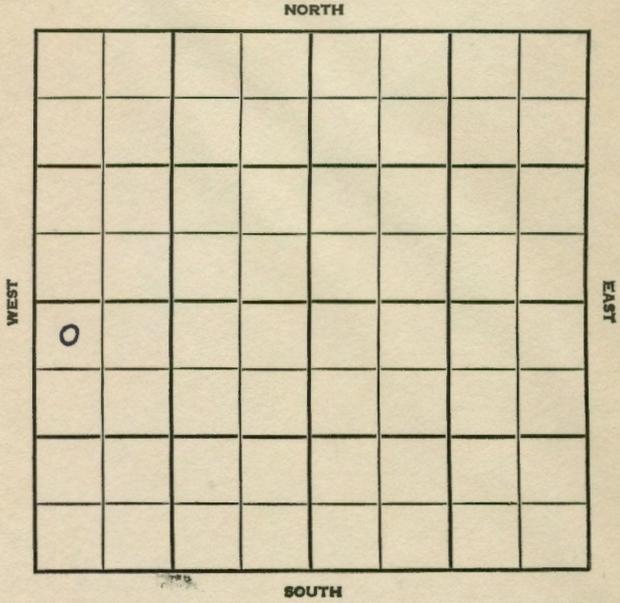

12

SEC.	32	TWP.	3	R.	24W
------	----	------	---	----	-----

WELL NO. 1 Brunson FARM

COMPANY Harry Gore


CONTRACTOR Empire Drlg.

330 Wildcat
Ft. from N. Line

_____ Ft. from S. Line

_____ Ft. from E. Line

330 _____ Ft. from W. Line

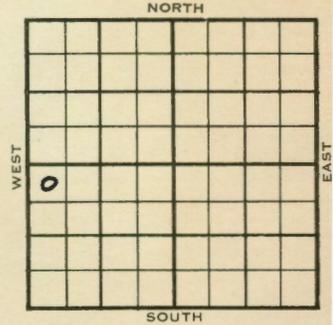

NW NW SW

Stanolind DHM

1954	ELEVATION <u>2466</u>	REPORT
------	--------------------------	--------

13/7 Spudding 7-10-54
8" @ 262
Drlg. 2700

7/21 Spudding 7-10-54
D&A
TD 3912
8" @ 262
Heeb 3474 Tor. 3502 KC 3515 BKC 3703
Cong. 3801
Arb. 3808 Gr. 3898
TD 3912
D&A

ABANDONED

County **Norton** State **Kansas**
 Sec. **32** (Blk. **3** (Sur. **24W** Map No.
 Operator **Harry Gore**
 Well No. **1** Farm **Brunson**
 Elev. Location **NW NW SW**

330 Ft. From **N** Line **SW**
330 Ft. From **W** Line Quarter
 Ist. Report **JUL 14 1954**
 Completion
 Remarks **Stanolind - DHM**
Empire Drlg. - Contr.
 Spudding Date **7-10-54**

Drlg. Data **Wildcat**
8" @ 262 drlg. 2700

J. G. McGEHEE

County **Norton** State **Kansas**
 Sec. **32** (Blk. **3** (Sur. **24W** Map No.
 Operator **Harry Gore**
 Well No. **1** Farm **Brunson**
 Elev. **2466** Location **NW NW SW**

330 Ft. From **N** Line **SW**
330 Ft. From **W** Line Quarter
 Ist. Report
 Completion **JUL 21 1954**
 Remarks **Wildcat**
Empire Drlg. - Contr.
 Spudding Date **7-10-54**

Drlg. Data **D & A TD 3912**
8" @ 262 Heeb. 3474 Tor. 3502
KC 3515 B KC 3703 Cong. 3801
Arb. 3808 Gr. 3898 TD 3912
D & A

J. G. McGEHEE