


Section 32 Township 3 Range 24W

Well No. #1 Brunson

Company C & G Drlg. & Aurora

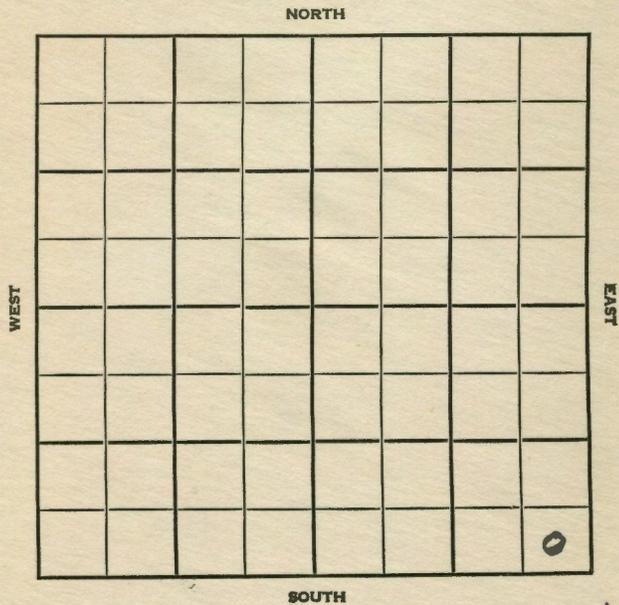

16

SEC. 32 TWP. 3 R. 24W

WELL NO. 1 Brunson FARM

COMPANY C & G Drlg & Aurora

CONTRACTOR C & G Drlg.

**Wildcat**

\_\_\_\_\_ Ft. from N. Line

\_\_\_\_\_ Ft. from S. Line

\_\_\_\_\_ Ft. from E. Line

\_\_\_\_\_ Ft. from W. Line

SE SE SE

**CRA - DHM**

	ELEVATION	REPORT
1955	<b>2401'</b>	
6/15	Comm 6-13-55 8" @ 329/225 WOC	
6/22	Comm 6-13-55 8" @ 329/225 anh 1962, H 3407, Tr 3434, L 3448 BKc 3631, R 3738, Gr Wash 3751 Gr 3785, TD 3842 D & A	<b>ABANDONED</b>

County Norton Elev. 2401 Co.

Sec. 32 Twp. 3 Rgs. 24W

Company C & G Drlg. & Aurora

FarmName Brunson No. 1

	TOPS	DEPTH	LOG	DATUM	Loc. in Sec.	
Anh.		<u>1962</u>			SE SE SE	
TP.	
H.		<u>3407</u>		<u>1006</u>	
Tr.		<u>3434</u>		<u>1033</u>	
Dg.					Geol.	
Bl.	
L.		<u>3448</u>		<u>1047</u>	Contr.	
K.C.	
B.K.C.		<u>3631</u>		<u>1230</u>	Lse. C & G Drlg.	
Ce.	
C.					Pool	
M.	
M.					Wildcat	
K.	
Mz.					<table border="1"> <tr><td></td><td></td><td></td><td></td></tr> </table>	
Me.	
V.	
S.	
A.	
R.		<u>3738</u>		<u>1337</u>	
Pe.	
G.		<u>3751</u>		<u>1350</u>	
Gr. Wash		<u>3785</u>		<u>1384</u>	
Gr.		<u>3842</u>	
TD.	

Date Comm. 6-13-55 JUN 22 1955 No.

8" @ 329/225 Sec.

D & A T.

R.

County Norton Elev. 2401 Co.

Sec. 32 Twp. 3 Rgs. 24W

Company C & G Drlg. & Aurora

FarmName Brunson No. 1

	TOPS	DEPTH	LOG	DATUM	Loc. in Sec.	
Anh.					SE SE SE	
TP.	
H.	
Tr.	
Dg.					Geol.	
Bl.	
L.					Contr.	
K.C.	
B.K.C.					Lse. C & G Drlg.	
Ce.	
C.					Pool	
M.	
M.					Wildcat	
K.	
Mz.					<table border="1"> <tr><td></td><td></td><td></td><td></td></tr> </table>	
Me.	
V.	
S.	
A.	
R.	
Pe.	
G.	
Gr. Wash	
Gr.	
TD.	

Date Comm. 6-13-55 JUN 15 '55 No.

8" @ 329/225 WOC Sec. CRA - DIM

K-15 T.

R.