


Section 34 Township 3 Range 21W

Well No. #1 Conover

Company Jones, Shelburne & Farmer.

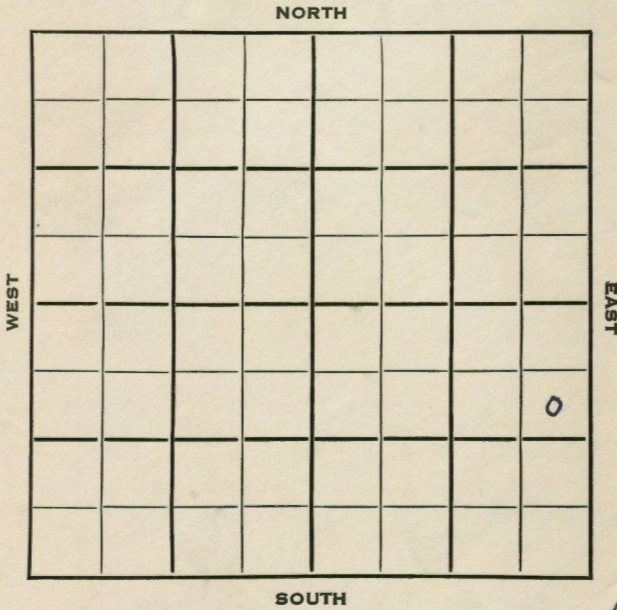

9

Sec. 34 Twp. 3 R. 21W

Well No. #1 Conover Farm

Jones, Shelburne & Farmer Company

J-S-F Contractor

Wildcat


990 Ft. from N. Line

Ft. from S. Line

330 Ft. from E. Line

Ft. from W. Line

SE NE SE

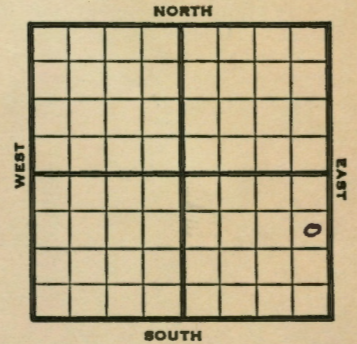

1953 **Elev. 2425'** REPORT

8/12 M I R  
 8/19 8" @ 285 **Anhy 2008**  
 Drlg. 3480'  
 8/26 Spud 8-11-53 D & A TD 3784'  
 8" @ 285 **Anhy 2008'** Heeb 3436  
**Lans 3483'**  
 DST 3626-58 open 1/4 hr. rec 6' mud  
 125# B KC 3663 Arb 3748  
 DST 3748-55 open 1 hr rec 1090' SW &  
 SO 1180# TD 3784 **Gr. 3784'**  
 D & A

**ABANDONED**

County Norton State Kansas  
 Sec. 34 (Blk. 3 (Sur. 24W Map No.  
 Operator Jones, Shelburne & Farmer  
 Well No. 1 Farm Conover  
 Elev. 2425 Location SE NE SE


990 Ft. From N Line SE  
330 Ft. From E Line Quarter  
 Ist. Report  
 Completion AUG 26 1953  
 Remarks Wildcat  
J-S-F - Contr.  
 Spudding Date 8-11-53

Drig. Data D & A TD 3784  
8" @ 285 Anhy 2008 Heeb. 3436 Lans.  
3483 DST 3626-58 open  $\frac{1}{4}$  hr. Rec.  
6' mud 125# B KC 3663 Arb. 3748  
DST 3749-55 open 1 hr. Rec. 1090' sw &  
SO 1180# TD 3784 Gr. 3784  
D & A

J. G. MCGEHEE

County Norton State Kansas  
 Sec. 34 (Blk. 3 (Sur. 24W Map No.  
 Operator Jones, Shelburne & Farmer  
 Well No. 1 Farm Conover  
 Elev. Location SE NE SE


990 Ft. From N Line SE  
330 Ft. From E Line Quarter  
 Ist. Report AUG 12 1953  
 Completion  
 Remarks  
J-S-F - Contr.  
 Spudding Date

Drig. Data Wildcat  
M I R

J. G. MCGEHEE