



Section 35 Township 3 Range 24W **KANSAS**
 Well No. #4 Schoen
 Company Derby Oil

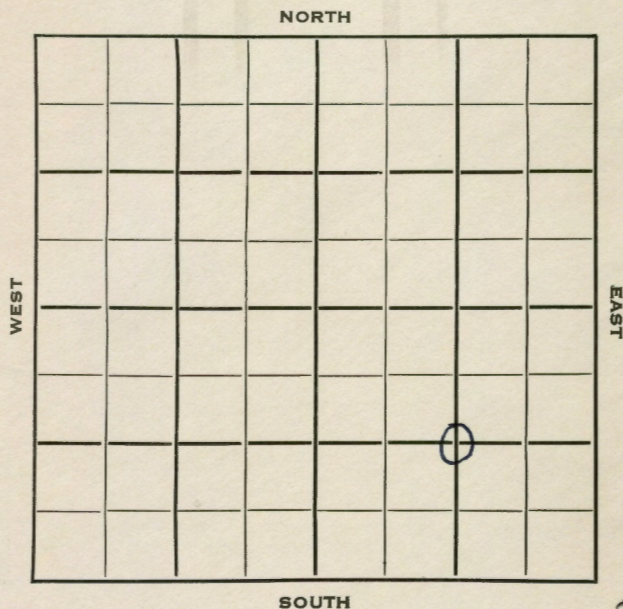

SEC. 35 TWP. 3 R. 24 W ✓
 WELL NO. #4 Schoen FARM
 COMPANY Derby Oil
 CONTRACTOR

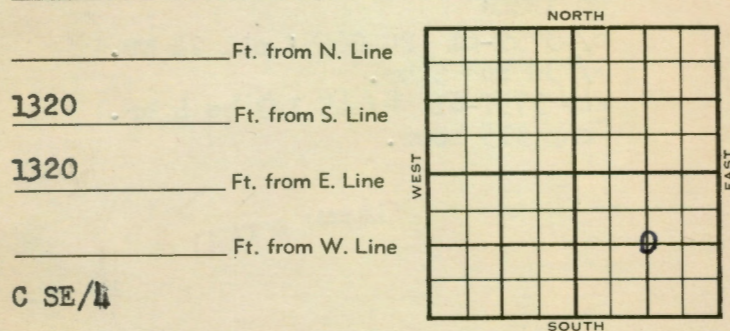

_____ Ft. from N. Line
1320 _____ Ft. from S. Line
1320 _____ Ft. from E. Line
 _____ Ft. from W. Line

C SE/4

	ELEVATION	REPORT
1953	2433'	
10/7	Spud 10-2-53 8" @ 285' Dr1g. 2985'	
10/14	Heeb 3445', Lans 3487', B KC 3669', Arb. 3746' DST 3753-62', 1/2 hrs., 1200' gas, 190' O&GCM, 600' oil, 1190# C 3762-78' DST 3762-67 1/2 hrs., 1420' SW + trace oil, 975# TD 3800' Granite 3797'	
10/21	5" @ 3776' 6 ?/ 3759-61, 2655' oil 24 hrs. S/30 bo 5 hrs. 24/3757-61	
10/28	S/45-1/3 BO 4 hrs.	
11/4	NR	
11/11	Spud 10-2-53 Oil Well TD 3800' 8" @ 285' Heeb 3445, Lans 3487, B KC 3669, Arb 3746,	

OVER


1953

Information brought forward.

11/11 DST 3753'-62' opn $\frac{1}{2}$ hr, rec 1200' gas
190' o & gcm, 600' oil, 1190#
DST 3762'-67' opn $\frac{1}{2}$ hr, rec 1420' sw
975# **Granite 3797'**,
5" @ 3776'
TD 3800'
6/ 3759-61 FU 2655' oil 24 hr.
S/ 30 bo 5 hr.
24/ 3757-61 S/ 45 $\frac{1}{3}$ bo 4 hr.
Comp 315 bopd.

COMPLETED

County Norton State Kansas
 Sec. 35 (Blk. 3 (Sur. 24W Map No.
 Operator Derby Oil
 Well No. 4 Farm Schoen
 Elev. 2433 Location C SE/4

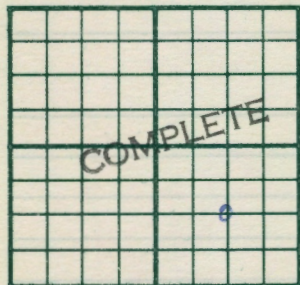

1320 Ft. From S Line SE
 1320 Ft. From E Line Quarter

1st. Report

Completion NOV 11 1953

Remarks

Spudding Date 10-2-53

Drlg. Data Oil well TD 3800

8" @ 285 Heeb. 3445 Lans. 3487

B KC 3669 Arb. 3746 DST 3753-62

open 1/2 hr. Rec. 1200' gas 190' o & gcm

600' oil 1190# DST 3762-67 open 1/2 hr.

Rec. 1420' sw 975# Granite 3797


5" @ 3776 TD 3800 6/ 3759-61 FU 2655'

oil 24 hr. S/ 30 bo 5 hr. 24/ 3757-61

S/ 45 1/3 bo 4 hr. Comp. 315 bopd

J. G. McGEHEE

County Norton State Kansas
 Sec. 35 (Blk. 3 (Sur. 24W Map No.
 Operator Derby Oil
 Well No. 4 Farm Schoen
 Elev. Location C SE/4

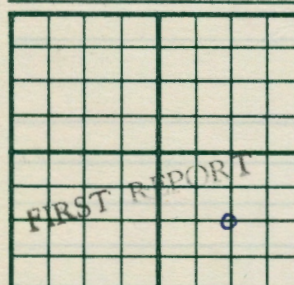

1320 Ft. From S Line SE

1320 Ft. From E Line Quarter

1st. Report OCT 7 1953

Completion

Remarks

Spudding Date 10-2-53

Drlg. Data

8" @ 285 drlg. 2985

J. G. McGEHEE