


Section 35 Township 3 Range 24 W

Well No. # 3 Schoen "A"

Company Jones, Shelburne & Farmer

NORTH

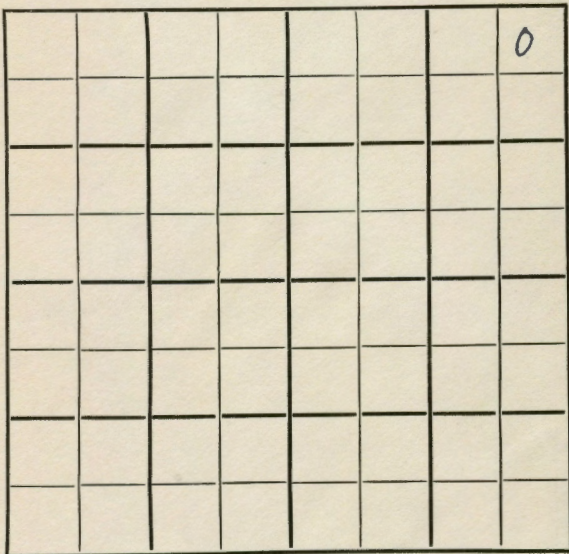

SOUTH

SEC. 35 TWP. 3 RANGE 24 W KANSAS

WELL NO. # 3 Schoen "A" FARM

COMPANY Jones, Shelburne & Farmer

CONTRACTOR J-S-F

Norton Pool

330 Ft. from N. Line


Ft. from S. Line

330 Ft. from E. Line

Ft. from W. Line

NE NE NE

NORTH

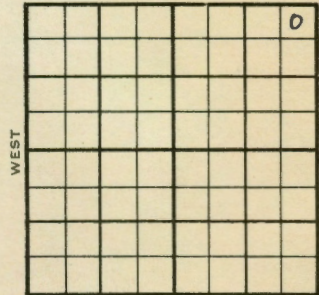

SOUTH

	ELEVATION	REPORT
1954	2473'	

2/3	Spud 2-2-54 Drlg. surface hole	
2/10	8" @ 280' Drlg. 3535'	
2/17	Heeb 3491 Tor 3517 Lans 3531 BKC 3716 Arb. 3786 RTD 3791 5" @ 3788	
2/24	WOCT	
3/3	"	
3/10	DD 3792' TD 2 BFPH 48 hrs. Est 35% wtr.	
3/17	WOP	
8/4	Spud 2-2-54 D&A TD 3792' 8" @ 280' Heeb 3491'; Tor 3517'; Lans 3531'; B KC 3716'; Arb. 3786' TD 3791' 5" @ 3788' DD 3792' 2 biph 35% wtr., wtr inc. D&A	

ABANDONED

