

KANSAS

Section 35 Township 3 Range 24W

Well No. #4 Schoen "A"

Company Jones, Shelburne & Farmer

NORTON KANSAS

SEC. 35 TWP. 3 R. 24W ✓

WELL NO. 4 Schoen "A" FARM

COMPANY Jones, Shelburne & Farmer

CONTRACTOR J-S-F

1320 Ft. from N. Line
440 Ft. from E. Line

Ft. from S. Line
Ft. from W. Line



C E/2 E/2 NE

1320 Ft. from N. Line

440 Ft. from E. Line

Ft. from S. Line
Ft. from W. Line

C E/2 E/2 NE

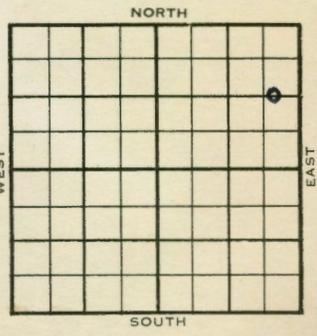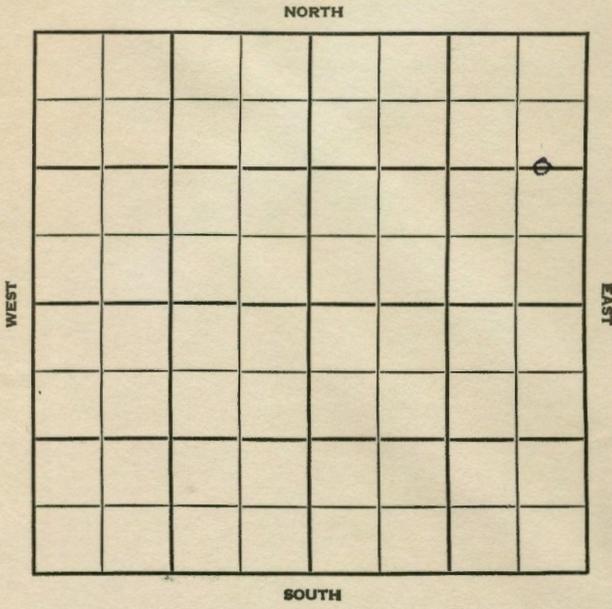

1954 ELEVATION 2466' REPORT

4/27 Spud 4-24-54
8" @ 266'

Anhy 2046'
Drlg. 2054'

5/5 Drlg. 3490'

6/23 Spud 4-24-54
Oil Well
TD 3788'

8" @ 266'

Anhy 2046' $\frac{1}{2}$ Heeb 3484', Tor 3510',
Lans 3525', Gorham 3780', Arb. 3785'

DST 3781-88', opn $\frac{1}{2}$ hrs., rec. 350'
gas, 550' oil, 770#
TD 3788'

5" @ 3782'
CO 3788'
S/9 boph 5 hrs.
Comp. 122 bopd

COMPLETED

