
FORM 51

Norton KANSAS

Section 36 Township 3 Range 24W

Well No. #1 Lawson

Company Benson & Montin

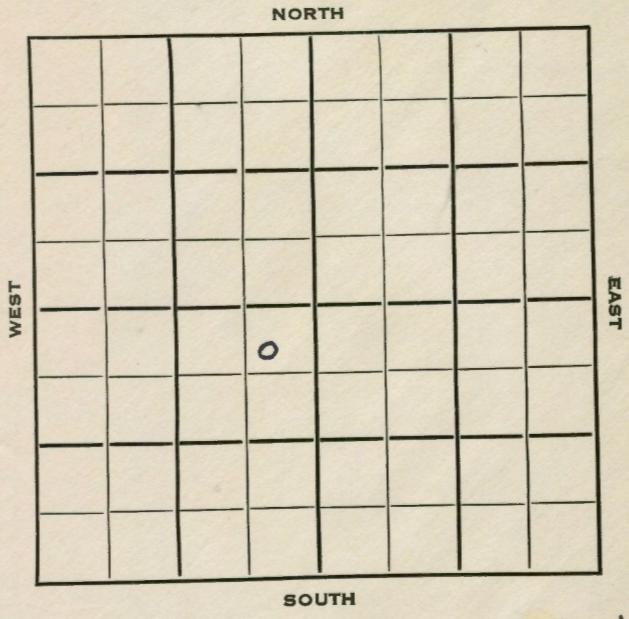

11

FORM 252-B

Norton KANSAS

Sec. 36 Twp. 3 R. 24W

Well No. #1 Lawson Farm

Benson & Montin Company

J-S-F
~~Norton Pool~~ Contractor


440 Ft. from N. Line

Ft. from S. Line

440 Ft. from E. Line

Ft. from W. Line

NE NE SW

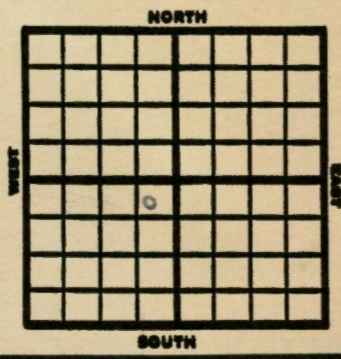

1953	REPORT
	Elev. 2457'
9/2	Location
9/9	10" @ 300' Heeb 3483, Tor 3504, Lans 3523 Drlg. 3562'
9/16	Arb. 3772' RTD 3775' 5" @ 3773 CO 3775' S/2½ BOPH 3 hrs DD 3777 S/7 BOPH 5 hrs.
9/23	POP
9/30	N.R.
10/7	Spud 9-2-53 Oil well TD 3777' 10" @ 300 Heeb 3483' Tor 3504' Lans 3523' Arb. 3772' TD 3775' 5" @ 3773 CO to 3775 S/2½ BOPH 3 hr. DD 3777' S/7 BOPH 5 hr. Comp. 124 BOPD
	COMPLETED

FORM 275 FOR SALE BY KANSAS BLUE PRINT CO.

County Norton State Kansas

Sec. 36 (Blk. Twp.) 3 (Sur. Rge.) 24W Map No.

Operator Brooks Hall, Benson & Montin

Well No. 1 Farm Lawson

Elev. 2457 Location NE NE SW



440 Ft. From N Line SW

440 Ft. From E Line Quarter

1st. Report

Completion OCT 7 1953

Remarks Norton Pool

J-S-F - Contr.

Spudding Date 9-2-53

Drlg. Data Oil well TD 3777

10" @ 300 Heeb. 3483 Tor. 3504

Lans. 3523 Arb. 3772 TD 3775

5" @ 3773 CO to 3775 S/ 2½ boph

3 hr. DD 3777 S/ 7 boph 5 hr.

Comp. 124 bopd

J. G. McGEHEE

FORM 275 FOR SALE BY KANSAS BLUE PRINT CO.

County Norton State Kansas

Sec. 36 (Blk. Twp.) 3 (Sur. Rge.) 24W Map No.

Operator Benson & Montin

Well No. 1 Farm Lawson

Elev. Location NE NE SW



440 Ft. From N Line SW

440 Ft. From E Line Quarter

1st. Report SEP 2 1953

Completion

Remarks

J-S-F - Contr.

Spudding Date

Drlg. Data Norton Pool

Location

J. G. McGEHEE