


Section 36 Township 3 Range 21W

Well No. #1 Lawson

Company Jones, Shelburne & Farmer.

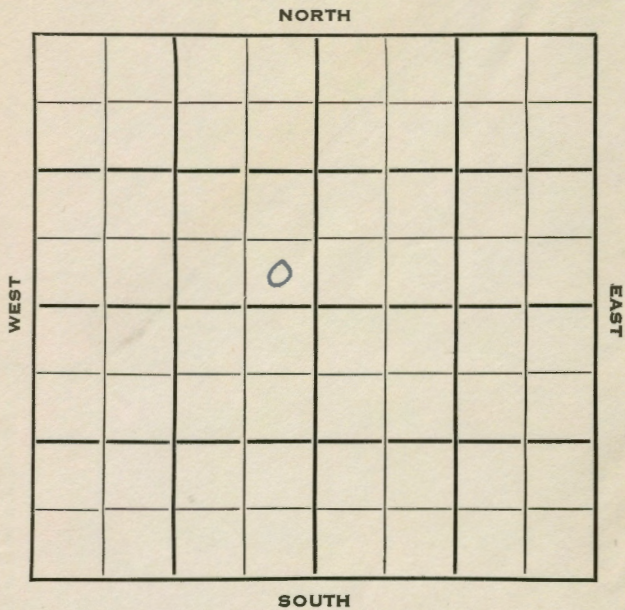

6
9

Sec. 36 Twp. 3 R. 21W

Well No. #1 Lawson Farm

Jones, Shelburne & Farmer Company

J-S-F
Wildcat


_____ Ft. from N. Line

330 Ft. from S. Line

330 Ft. from E. Line

_____ Ft. from W. Line

SE SE NW

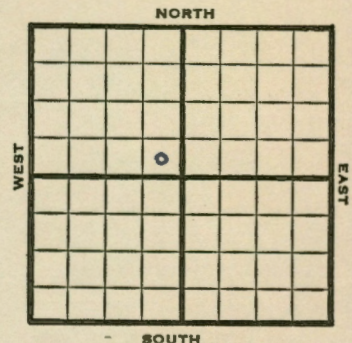

1953	Elev. 2467'	REPORT
4/29	M I R	
5/7	8" @ 165'	Anhy 2060' Drlg. 3394'
5/21	Top 3315'	Heeb 3491' Tor 3515' Lans. 3532' DST 3532-62, 1 hr, 300' SW 1150# Arb. 3778' DST 3779-90, 1 hr, 540' gas, 1110' free oil, G. 38 1360# RTD 3790 5" @ 3779 CO 3790 FU 2850' oil 12 hrs. S/12 BOPH 4 hrs. POP
5/28	N.R.	
6/3	"	
6/10	Spud 4-28-53 Oil Well TD 3790 8" @ 165'	Anhy 2060, Top 3315, Heeb 3491, Tor 3515, Lans 3532, DST 3532-62 opn 1 hr, rec 300' sw 1150# Arb 3778 DST 3779-90 opn 1 hr, rec 540' gas, 1110' free oil, 1360# TD 3790' 5" @ 3779' CO to 3790

OVER

1953

Information brought forward.

6/10

FU 2850' oil 12 hr. S/ 12 boph
4 hr.

Comp 200 bopd.

COMPLETED

