


Section 36 Township 3 Range 24W
 Well No. 8 Lawson
 Company Harry Gore

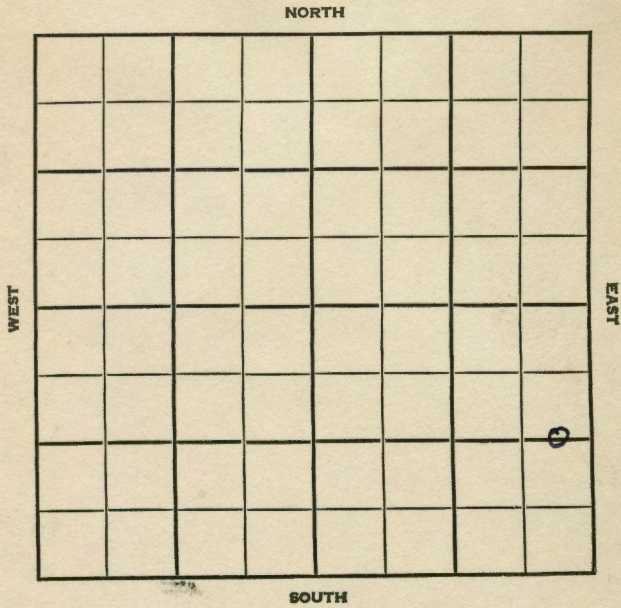


9

Norton KANSAS

SEC. 36 TWP. 3 R. 24W
 WELL NO. 8 Lawson FARM
 COMPANY Harry Gore
 CONTRACTOR _____

_____ Ft. from N. Line
1320
 _____ Ft. from S. Line
330
 _____ Ft. from E. Line
 _____ Ft. from W. Line

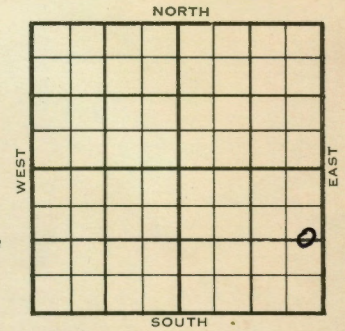

C E $\frac{1}{2}$ E $\frac{1}{2}$ SE

	ELEVATION	REPORT
1954	2462	
7/7 7/14	Spudding 7-1-54 8" @ 263 Arb 3786 TD 3793 5" @ 3787	
7/21	Heeb 3497' Tor 3522' KC 3533 B KC 3720 Arb. 3786'	
8-11	Spdg 7-1-54 Oil well TD 3794 8" @ 263 Heeb 3497 Tor. 3522 KC 3533 BKC 3720 Arb. 3786 TD 3793 5" @ 3787 DD 3794 500 A P/ boph Comp. 324 bopd	

COMPLETED

