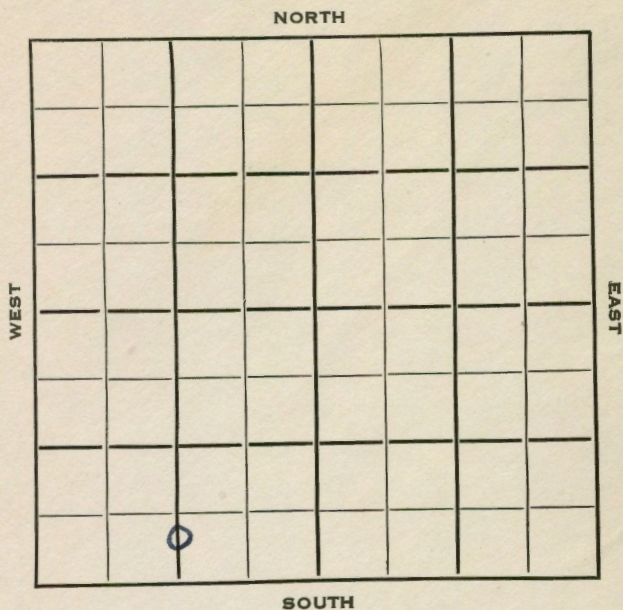


Norton **KANSAS**Section 36 Township 3 Range 24 WWell No. # 8 LawsonCompany Benson & Montain

14

SEC. <u>36</u>	TWP. <u>3</u>	R. <u>24W</u> ✓
WELL NO. <u>#8 Lawson</u>		
COMPANY <u>Benson & Montain</u>		
CONTRACTOR <u>J-S-F</u>		

Norton Pool

Ft. from N. Line	Ft. from S. Line	Ft. from E. Line
<u>440</u>		
<u>1320</u>		

Ft. from W. Line

C S $\frac{1}{2}$ S $\frac{1}{2}$ SW

SOUTH

DATE	ELEVATION	REPORT
1953	2464'	
11/18	Spud 11-10-53 8" @ 240' Anhy 2048' Drlg 2444'	
1954 3/3	Spud 11-10-53 Oil Well TD 3787' 8" @ 240' Anhy 2048', Heeb 3493', Tor 3518', Lans 3533', B KC 3718', Arb. 3784' TD 3787' 5" @ 3785' CO to 3787' S/l boph Comp. 162 bopd	

COMPLETED

DX-78

County Norton State Kansas
 Sec. 36 (Blk. 3 (Sur. 24W Map No.
 Operator Benson & Montain
 Well No. 8 Farm Lawson
 Elev. 2464 Location C S $\frac{1}{2}$ S $\frac{1}{2}$ SW



440 Ft. From S Line SW
1320 Ft. From W Line Quarter
 1st. Report
 Completion MAR 3 1954
 Remarks Norton Pool
J-S-F - Contr.
 Spudding Date 11-10-53

Drig. Data Oil well TD 3787
8" @ 240 Anhy 2048 Heeb. 3493
Tor. 3518 Lans. 3533 B KC 3718
Arb. 3784 TD 3787 5" @ 3785
CO to 3787 S/ 1 boph Comp. 162 bopd

J. G. McGEHEE

County Norton State Kansas
 Sec. 36 (Blk. 3 (Sur. 24W Map No.
 Operator Benson & Montain
 Well No. 8 Farm Lawson
 Elev. Location C S $\frac{1}{2}$ S $\frac{1}{2}$ SW



440 Ft. From S Line SW
1320 Ft. From W Line Quarter
 1st. Report NOV 18 1953
 Completion
 Remarks
J-S-F - Contr.
 Spudding Date 11-10-53

Drig. Data Norton Pool
8" @ 240 Anhy 2048 drig. 2444

J. G. McGEHEE