


Section 36 Township 3 Range 24W

Well No. 9 Lawson

Company Jones, Shelburne & Farmer

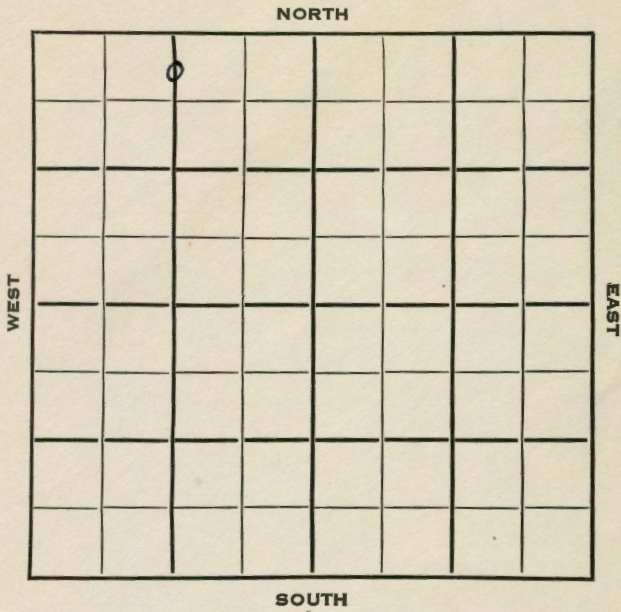

3

SEC. 36 TWP. 3 R. 24W ✓

WELL NO. #9 Lawson FARM

COMPANY Jones, Shelburne & Farmer

CONTRACTOR

Norton Pool

440 Ft. from N. Line

Ft. from S. Line

Ft. from E. Line

1320 Ft. from W. Line

C N $\frac{1}{2}$  N $\frac{1}{2}$  NW

| DATE | ELEVATION | REPORT  |
|------|-----------|---|
| 1954 | 2409'     |   |
| 4/14 |           | Location  |
| 6/23 |           | Spud 4-15-54<br>Oil Well<br>TD 3729'<br>8" @ 278'<br>Anhy 1989', Heeb 3432', KC 3471',<br>B KC 3660'<br>TD 3726'<br>5" @ 3724'<br>Arb. 3721'<br>DD <del>3729</del> 3729'<br>S/6 boph<br>Comp. 195 bopd 4 bw |
|      |           | <b>COMPLETED</b>  |

