


Norton

KANSAS

Section 36 Township 3 Range 24WWell No. #6 Chas. LawsonCompany Harry Gore.

NORTH

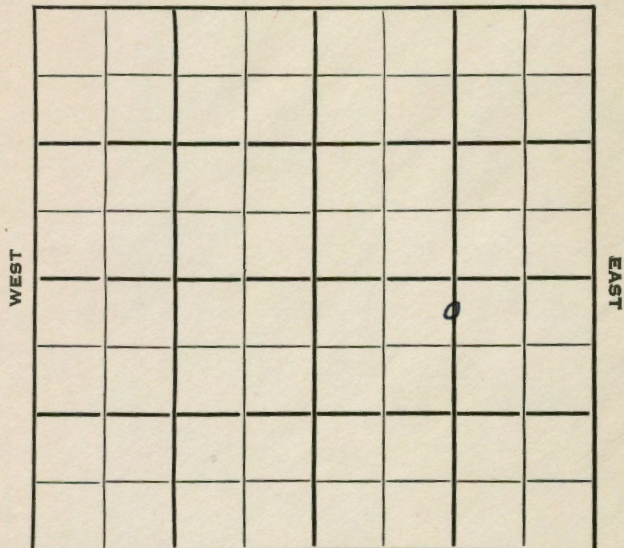

SOUTH

9

SEC. 36 TWP. 3 R. 24W ✓

WELL NO. 6 Chas. Lawson FARMCOMPANY Harry GoreCONTRACTOR Empire Drlg.Norton Pool440 Ft. from N. Line


Ft. from S. Line

1320 Ft. from E. Line

Ft. from W. Line

C N/2 N/2 SE

NORTH

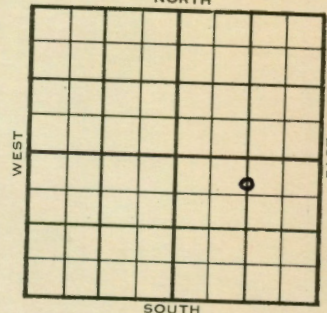

SOUTH

1954

ELEVATION

2433'

REPORT

3/10

Spud 3-6-54

8" @ 283'

Drlg. 2880'

3/17

Top 3316 Heeb 3467 Tor 3491

KC 3507' B KC 3688 Arb. 3759

RTD 3762 5" @ 3761

3/24

DD 3763 P/140 BO 17 hrs.

3/31

NR

4/21

Spud 3-6-54

Oil Well

TD 3763'

8" @ 283'

Top 3316', Heeb 3467', Tor 3491', KC 3507', B KC 3688', Arb. 3759'

TD 3762'

5" @ 3761'

DD 3763

P/140 bo 17 hrs.

Comp. 198 bopd

COMPLETED

County **Norton** State **Kansas**
 Sec. **36** (Blk. **3** (Sur. **24W** Map No.
 Operator **Harry Gore**
 Well No. **6** Farm **Chas. Lawson**
 Elev. **2433** Location **C N $\frac{1}{2}$ N $\frac{1}{2}$ SE**

440 Ft. From **N** Line **SE**
1320 Ft. From **E** Line **Quarter**
 1st. Report **MAR 10 1954**
 Completion
 Remarks
Empire Drlg. - Contr.
 Spudding Date **3-6-54**

Drlg. Data

8" @ 283 drlg. 2880

Norton Pool

J. G. McGEHEE

County **Norton** State **Kansas**
 Sec. **36** (Blk. **3** (Sur. **24W** Map No.
 Operator **Harry Gore**
 Well No. **6** Farm **Chas. Lawson**
 Elev. **2433** Location **C N $\frac{1}{2}$ N $\frac{1}{2}$ SE**

440 Ft. From **N** Line **SE**
1320 Ft. From **E** Line **Quarter**
 1st. Report
 Completion **APR 21 1954**
 Remarks **Norton Pool**
Empire Drlg. - Contr.
 Spudding Date **3-6-54**

Drlg. Data

Oil well TD 3763

8" @ 283 Top. 3316 Heeb. 3467

Tor. 3491 KC 3507 B KC 3688 Arb. 3759

TD 3762 5" @ 3761 DD 3763 P/ 140 bo

17 hr. Comp. 198 bopd

J. G. McGEHEE