


Norton KANSAS

Section 35 Township 3 Range 24 W
 Well No. # 5 Schoen "A"
 Company Jones, Shelburne & Farmer

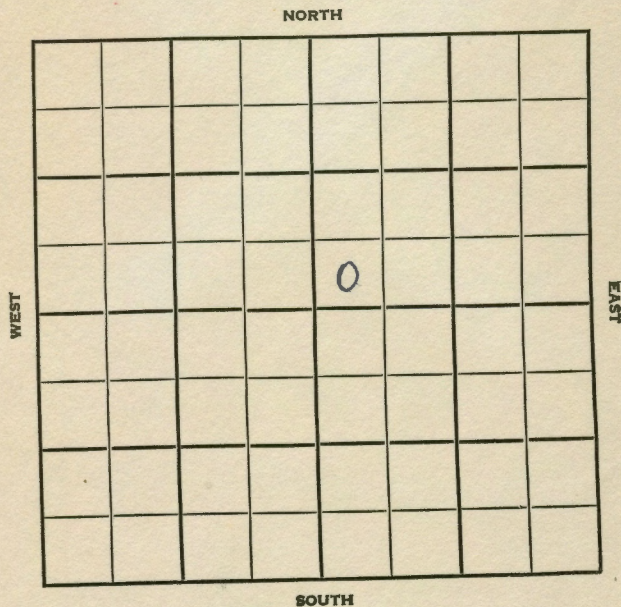

7


Norton KANSAS

SEC.	TWP.	R.
35	3	24 W

WELL NO. # 5 Schoen "A" FARM

COMPANY Jones, Shelburne & Farmer

CONTRACTOR Co. tools

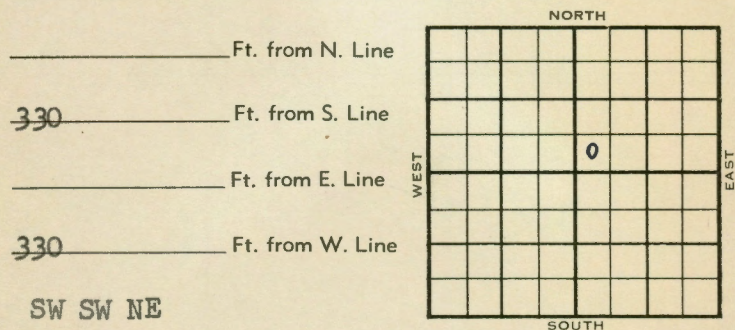

	ELEVATION	REPORT
1954	2442'	
9/22	Spud 9-9-54 8" @ 273 Anhy 2013, Heeb 3455' KC 3496', BKC 3681', Arb. 3753' 5" @ 3754 DST 3754-58, 540' gas, 660' free oil 660# RTD 3758'	
10/6	Spud 9-9-54 - Oil Well TD 3758' 8" @ 273' Anhy 2013', Heeb 3455', KC 3496', B KC 3681', Arb. 3753' 5" @ 3754' DST 3754-58' FU 540' gas, 660' g free oil 660# TD 3758' CO to TD S/12 boph FU 1750' oil Comp. 160 bopd	

COMPLETED

FABEN GILSTRAP

FABEN GILSTRAP