


DX 78-1 Norton

KANSAS

Section 35 Township 3 Range 24W

Well No. #7 Schoen "A"

Company Jones, Shelburne & Farmer

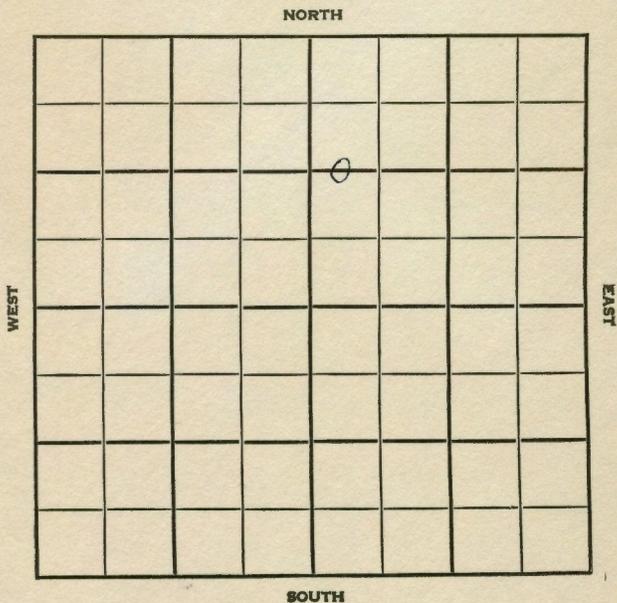

Norton

SEC.	TWP.	R.
35	3	24W

WELL NO. #7 Schoen "A" FARM

COMPANY Jones, Shelburne & Farmer

CONTRACTOR Co. Tools.

1320 Ft. from N. Line


_____ Ft. from S. Line

_____ Ft. from E. Line

440 Ft. from W. Line

$W\frac{1}{2}$ $W\frac{1}{2}$ NE

Norton Pool

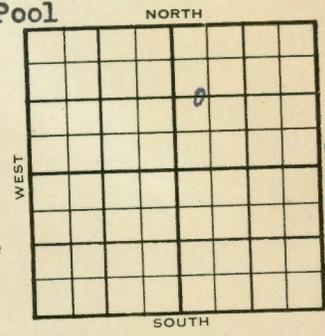

1954	ELEVATION	REPORT
	2462'	
11/17	m i r	
12/15	Spud 11-17-54 Oil Well TD 3785' 8-5/8" @ 296' Anhy 2035', Heeb 3481' Tor. 3505' Lans 3519', Reagan 3780' DST 3782'-85' opn 1 hr, rec 240' gas 125' Muddy Oil, 605# 5" @ 3782' TD 3785' CO to 3785' S/ 1 1/4 boph sd-frac. S/ 3 boph Comp 48 bopd. 35% Wtr.	

COMPLETED

DX-78

