


Section 36 Township 3 Range 24 W

Well No. # 3 Lawson

Company Jones, Shelburne & Farmer

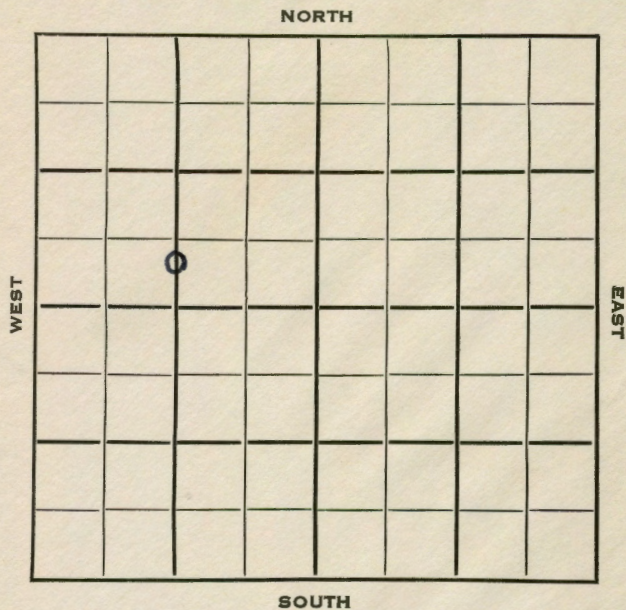

6

Norton KANSAS

SEC. 36	TWP. 3	R. 24W	
---------	--------	--------	--

WELL NO. #3 Lawson FARM

COMPANY Jones, Shelburne & Farmer

CONTRACTOR J-S-F

Norton Pool

_____ Ft. from N. Line

440 _____ Ft. from S. Line

_____ Ft. from E. Line

1320 _____ Ft. from W. Line

C S $\frac{1}{2}$ S $\frac{1}{2}$ NW

1953	ELEVATION	REPORT
	2466'	
10/14		Spud 10-10-53 8" @ 280' Anhy 2045' Drlg 2746'
10/21		Heeb 3484', Tor 3510', Lans 3524', B KC 3710 Drlg. 3765'
10/28		Arb. 3777-83' RTD 5" @ 3779'
11/4		NR
11/11		CO 3783' 12 BOPH
11/18		NR
12/9		Spud 10-10-53 Oil well TD 3783 8" @ 280 Anhy 2045 Heeb 3484' Tor. 3510' Lans 3524 B KC 3710 Arb. 3777 TD 3783 5" @ 3779 CO to 3783' 12 BOPH Comp. 253 BOPD
COMPLETED		

