


Section 36 Township 3 Range 24W

Well No. #5 Lawson

Company Harry Gore

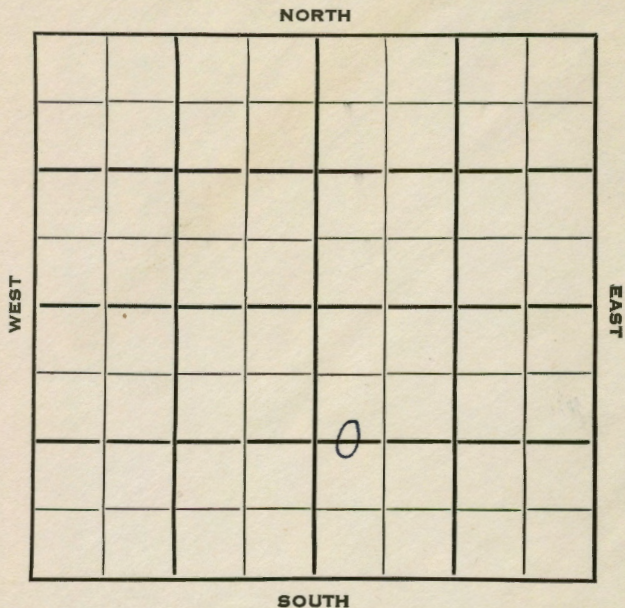

10

36 3 24 W ✓

WELL NO. #5 Lawson FARM

COMPANY Harry Gore

CONTRACTOR Empire Drlg. Norton Pool


Ft. from N. Line

1320 Ft. from S. Line

Ft. from E. Line

440 Ft. from W. Line

C W/2 W/2 SE

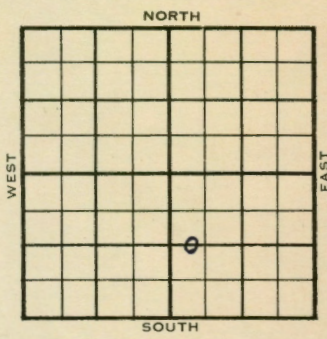

ELEVATION REPORT

1954	<del>2442'</del> 2446'
1/6	Location
1/13	"
1/20	"
1/27	"
2/3	8" @ 258 w/125 Drlg. 1125'
2/10	Drlg. 3620'
2/17	Heeb 3482 Tor 3504 Lans 3522 B KC 3703 Arb. 3772 RTD 3775 5" @ 3774
2/24	WOCT
3/3	"
3/10	DD 3778' TD 10 BOPH POP
3/17	Spud 1-30-54 Oil Well TD 3778' 8" @ 258' Heeb 3482', Tor 3504', Lans 3522', B KC 3703', Arb. 3772' TD 3775' 5" @ 3774' DD 3778' 10 boph Comp. 215 bopd

COMPLETED

