


KANSAS

Section 36 Township 3 Range 24W
 Well No. #6 Stapleton
 Company Nate Appleman

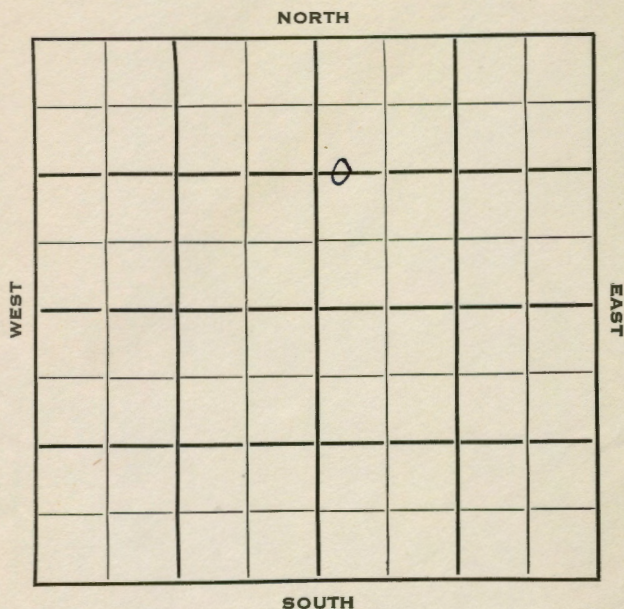

2

Norton

KANSAS

SEC. 36 TWP. 3 R. 24 W ✓
 WELL NO. # 6 Stapleton FARM
 COMPANY Nate Appleman
 CONTRACTOR J-S-F


Norton Pool

1320 Ft. from N. Line

Ft. from S. Line

Ft. from E. Line

440 Ft. from W. Line

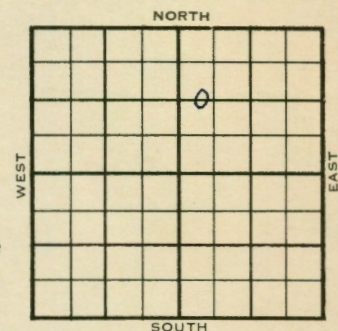C W $\frac{1}{2}$ W $\frac{1}{2}$ NE

	ELEVATION	REPORT
1954	2440'	
1/27	Spud 1-23-54 8" @ 280 Anhy 2023' Drlg. 2042'	
2/3	Heeb 3462' Tor 3488' Lans 3501' B KC 3690' Arb. 3748' RTD 3752' 5" @ 3749	
2/10	DD 3754' TD, 500A S/8 BOPH 6 hrs., POP	
2/17	NR	
3/3	NR	
4/21	Spud 1-23-54 Oil Well TD 3754' 8" @ 280' Anhy 2023', Heeb 3462', Tor 3488', Lans 3501', B KC 3690', Arb. 3748' TD 3752' 5" @ 3749' DD 3754, 500A S/8 boph 6 hrs. Comp. 301 bopd	
COMPLETED		

County Norton State Kansas
 Sec. 36 (Blk.) 3 (Sur.) 24W Map No.
 Operator Nate Appleman
 Well No. 6 Farm Stapleton
 Elev. 2440 Location C W $\frac{1}{2}$ W $\frac{1}{2}$ NE




1320 Ft. From N Line NE
440 Ft. From W Line Quarter
 1st. Report
 Completion APR 21 1954
 Remarks Norton Pool
J-S-F - Contr.
 Spudding Date 1-23-54

Drig. Data Oil well TD 3754
8" @ 280 Anhy 2023 Heeb. 3462
Tor. 3488 Lans. 3501 B KC 3690
Arb. 3748 TD 3752 5" @ 3749 DD 3754
500 A S/ 8 boph 6 hr.
Comp. 301 bopd

J. G. McGEHEE

County Norton State Kansas
 Sec. 36 (Blk.) 3 (Sur.) 24W Map No.
 Operator Nate Appleman
 Well No. 6 Farm Stapleton
 Elev. 2440 Location C W $\frac{1}{2}$ W $\frac{1}{2}$ NE

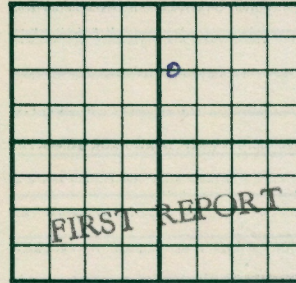

1320 Ft. From N Line NE
440 Ft. From W Line Quarter
 1st. Report JAN 27 1954
 Completion
 Remarks
J-S-F - Contr.
 Spudding Date 1-23-54

Drig. Data Norton Pool
8" @ 280 Anhy 2023 drig. 2042

J. G. McGEHEE