



Norton KANSAS

Section 36 Township 3 Range 24 W  
Well No. # 7 Stapleton  
Company Nate Appleman

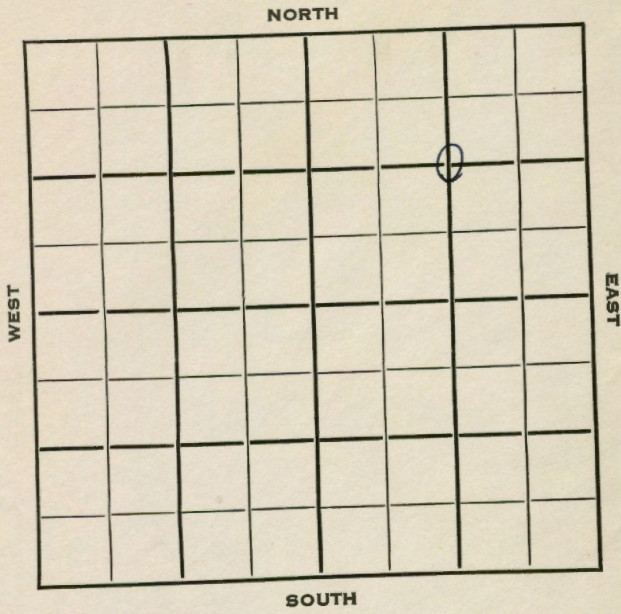

Norton  
SEC. 36 TWP. 3 R. 24 W ✓  
WELL NO. # 7 Stapleton FARM  
COMPANY  
CONTRACTOR Nate Appleman  
J-S-F

Norton Pool  
1320 Ft. from N. Line  
Ft. from S. Line  
1320 Ft. from E. Line  
Ft. from W. Line  
C NE/4

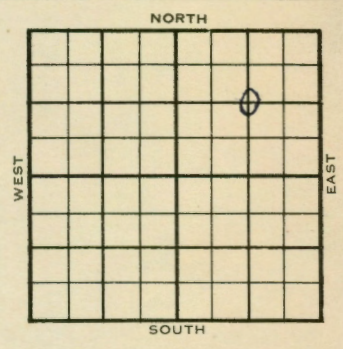

	ELEVATION	REPORT
1954	2443'	
2/3		Spud 2-2-54 Drlg. surface hole
2/10		NR
2/17		8" @ 280 w/125 Anhy 2023 Drlg. 3050'
2/24		Heeb 3467 Lans 3508' Arb. 3751 RTD 3756 5" @ 3752
3/3		CO 3756 S/4 BOPH 500 A
3/10		11 BOPH
3/17		NR
4/21		Spud 2-2-54 OilWell TD 3756' 8" @ 280' Anhy 2023', Heeb 3467', Lans 3508', Arb. 3751' TD 3756' 5" @ 3752' CO to 3756 S/4 boph 500A 11 boph omp. 240 bopd

COMPLETED

