


Section 36 Township 3 Range 24W
 Well No. 8 Stapleton
 Company Nate Appleman

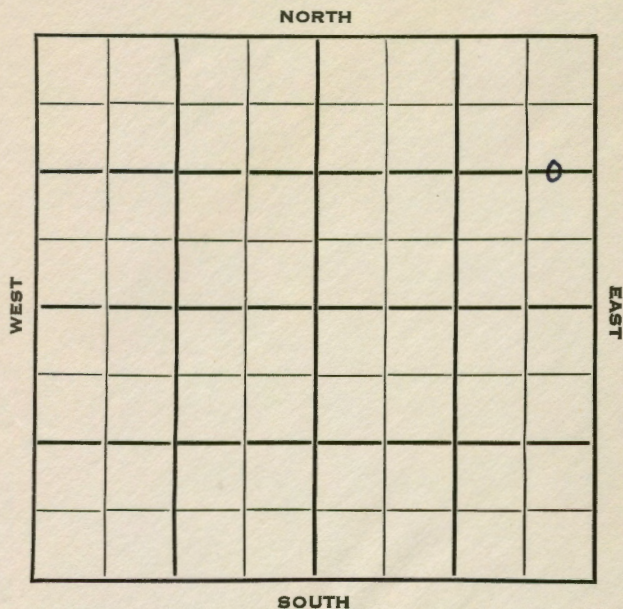

Norton KANSAS

SEC.	TWP.	R.
36	3	24 W ✓

WELL NO. # 8 Stapleton FARM

COMPANY Nate Appleman

CONTRACTOR J-S-F

Norton Pool


 Ft. from N. Line

1320 Ft. from S. Line

440 Ft. from E. Line

 Ft. from W. Line

C E $\frac{1}{2}$ E $\frac{1}{2}$ NE

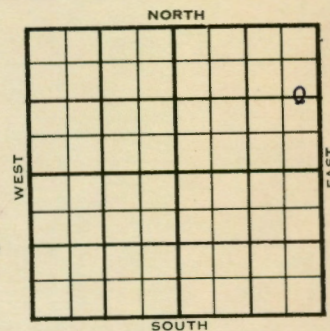

	ELEVATION	REPORT
1954	2376'	
2/24	Spud 2-22-54 8" @ 280	
3/3	Anhy 1963' Drlg. 3502'	
3/10	Heeb 3404' Tor 3430 Lans 3443 B KC 3630 Arb. 3693 RTD 3698 5" @ 3694	
3/17	WOCT	
3/24	CO 3698 SSO DD 3701 S/2 BOPH 500 A S/5 $\frac{1}{2}$ BOPH	
3/31	NR	
5/5	Spud 2-22-54 Oil Well TD 3701' 8" @ 280' Anhy 1963', Heeb 3404', Tor 3430' Lans 3443', B KC 3630', Arb 3693' TD 3698' 5" @ 3694' CO to 3698' DD 3701' S/ 2 boph 500 A S/ 5 $\frac{1}{2}$ boph Comp 261 boph.	

COMPLETED

J. G. McGEHEE

J. G. McGEHEE