


Norton KANSAS

Section 36 Township 3 Range 24 W

Well No. # 3 Stapleton

Company Nate Appleman & Aurora Gasline

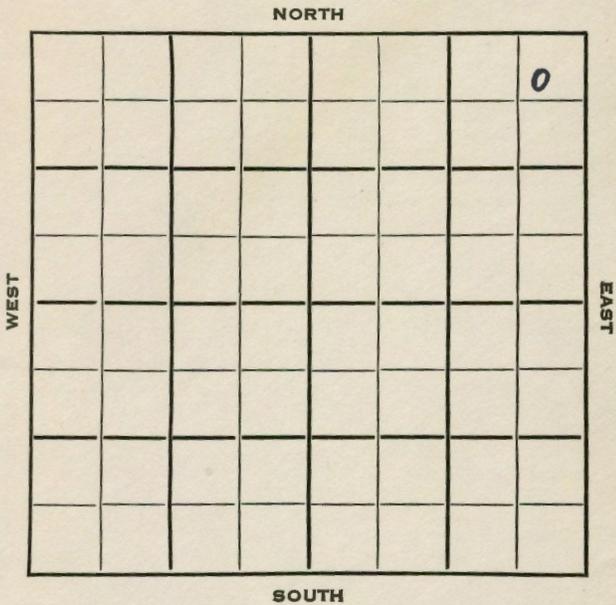

SEC. 36 TWP. 3 R. 24W

WELL NO. #3 Stapleton

COMPANY Nate Appleman & Aurora Gasline FARM


CONTRACTOR J*S-F

440 Ft. from N. Line

440 Ft. from S. Line

440 Ft. from E. Line

Ft. from W. Line

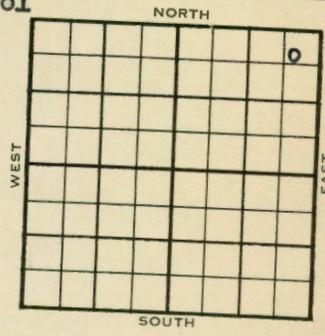

NE NE NE

1953 ^{2457' LS} 2441' RB REPORT

- 9/9 Spud 9-3-53 Heeb 3462, Tor 3489, Lans 3504 Drlg. 3577'
- 9/16 Arb. 3746' RTD 3751' 5" @ 3747'
- 9/23 NR
- 10/7 Spud 9-3-53 Oil well TD 3755' Heeb 3462' Tor. 3489' Lans 3504' Arb. 3746' TD 3751' 5" @ 3747 DD 3755' 1000 A S/13 BOFH Comp. 343 BOPD

COMPLETED

