


Section 36 Township 3 Range 24 W
 Well No. # 4 Stappleton
 Company Nate Appleman

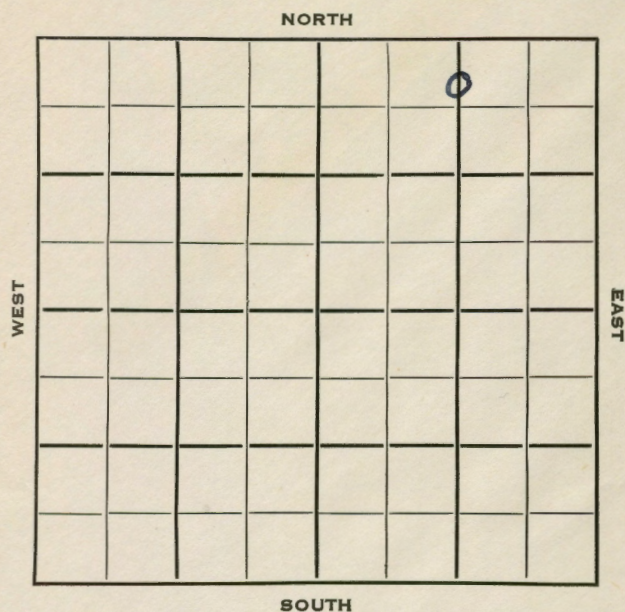

SEC. 36 TWP. 3 R. 24 W ✓
 WELL NO. # 4 Stappleton FARM
 COMPANY Nate Appleman
 CONTRACTOR J-S-F

Norton Pool


440 Ft. from N. Line

Ft. from S. Line

1320 Ft. from E. Line

Ft. from W. Line

C N $\frac{1}{2}$ N $\frac{1}{2}$ NE

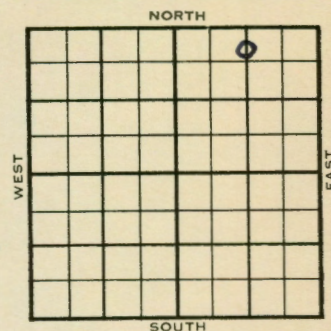

	ELEVATION	REPORT
1953	2444'	
11/24	Location	
12/9	"	
12/16	"	
1954		
1/6	8" @ 289 Drlg. 2415'	
1/13	Heeb 3471' Tor. 3495' Lans. 3510' Arb. 3754' RTD 3759' 5" @ 3755'	
1/20	CO 3759', 1 $\frac{1}{2}$ boph DD 3760, 2 boph DD 3761 TD 2 $\frac{1}{2}$ BOPH 500A S/7 $\frac{1}{2}$ boph 4 hrs.	
1/27	NR	
2/10	NR	
2/17	Spud 1-3-54 Oil Well TD 3761' 8" @ 289' Heeb 3471', Tor 3495', Lans 3510' Arb 3754' TD 3759' 5" @ 3755' CO to 3759 1 $\frac{1}{2}$ boph DD 3760 2 boph DD 3761	

1954


Information brought forward.

2/17

$2\frac{1}{4}$ boph 500 A $7\frac{1}{2}$ boph
Comp 198 bopd.

COMPLETED

County Norton State Kansas
 Sec. 36 (Blk. 3 (Sur. 24W Map No.
 (Twp.) (Rge.)
 Operator Nate Appleman
 Well No. 4 Farm Stapleton
 Elev. 2444 Location C N $\frac{1}{2}$ N $\frac{1}{2}$ NE

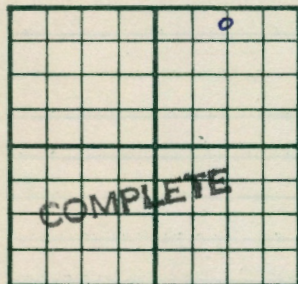


440 Ft. From N Line NE
1320 Ft. From E Line Quarter
 1st. Report
 Completion FEB 17 1954
 Remarks Norton Pool
J-S-F - Contr.
 Spudding Date 1-3-54

Drig. Data Oil well TD 3761
8" @ 289 Heeb. 3471 Tor. 3495
Lans. 3510 Arb. 3754 TD 3759 5" @ 3755
CO to 3759 1 $\frac{1}{2}$ boph DD 3760 2 boph
DD 3761 2 $\frac{1}{2}$ boph 500 A 7 $\frac{1}{2}$ boph
Comp. 198 bopd

J. G. McGEHEE

County Norton State Kansas
 Sec. 36 (Blk. 3 (Sur. 24W Map No.
 (Twp.) (Rge.)
 Operator Nate Appleman
 Well No. 4 Farm Stapleton
 Elev. Location C N $\frac{1}{2}$ N $\frac{1}{2}$ NE

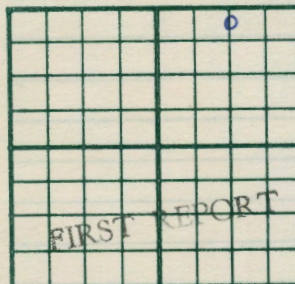

440 Ft. From N Line NE
1320 Ft. From E Line Quarter
 1st. Report NOV 24 1953
 Completion
 Remarks
J-S-F - Contr.
 Spudding Date

Drig. Data Norton Pool

Location

J. G. McGEHEE