


KANSAS

Section 8 Township 3 Range 25W

Well No. #1 Leichliter

Company Henderson Oil

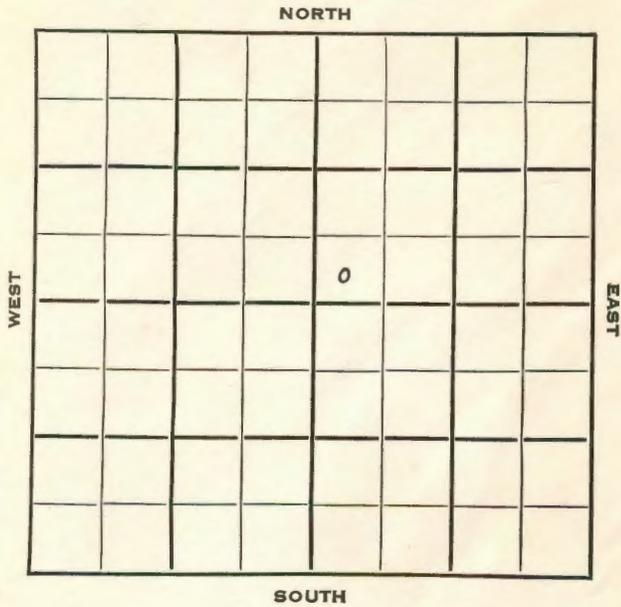


7

SEC. <u>8</u>	TWP. <u>3</u>	R. <u>25W</u> ✓
WELL NO. <u>#1 Leichliter</u> FARM		
COMPANY <u>Henderson Oil</u>		
CONTRACTOR		

Wildcat

_____ Ft. from N. Line
330 Ft. from S. Line
 _____ Ft. from E. Line
330 Ft. from W. Line

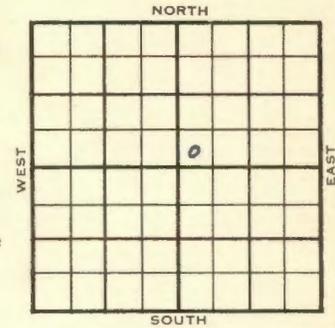

SW SW NE
Sinclair acreage Sohio - DHM

	ELEVATION	REPORT
1954	2537'	
3/2	Spud 2-27-54 8" @ 282' Drlg 2004'	
3/10	Spud 2-27-54 D & A TD 3958 8" @ 282 Heeb 3486 "ans 3526 DST 3540-92 open 1/2 hr rec 22' mud 1100# B KC 3726 Arb. 3898 TD 3958 D & A	
ABANDONED		

