


Section 10 Township 3 Range 25W

Well No. #1 Mizell

Company Russ-Shields

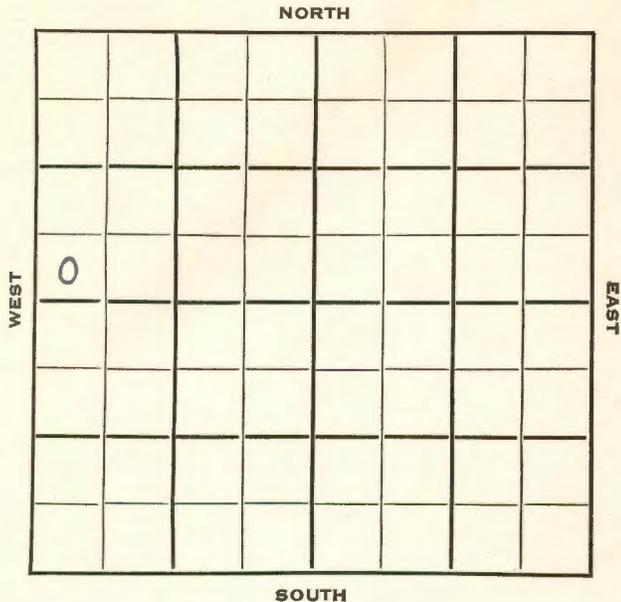

SEC.	TWP.	R.
10	3	25 W ✓

WELL NO. # 1 Mizell FARM

COMPANY Russ-Shields

CONTRACTOR Peel-Hardman Wildcat


\_\_\_\_\_ Ft. from N. Line

330 \_\_\_\_\_ Ft. from S. Line

\_\_\_\_\_ Ft. from E. Line

330 \_\_\_\_\_ Ft. from W. Line

SW SW NW

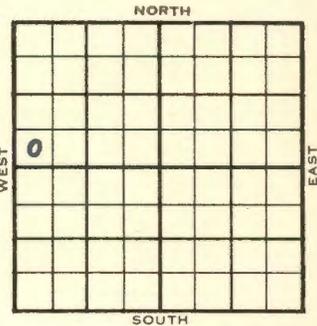

1953	ELEVATION	REPORT
	<u>2508'</u>	

11/11 Location  
11/18 C & P  
12/9 Heeb 3461 Lans 3497

DST 3499-3511 1 hr, 40' wtr.  
DST 3523-71, 3/4 hr, 15' free oil,  
60' Hvly OCM 235# B KC 3709  
Cong. 3809 G. Wash 3880'  
RTD 3902' 5" @ 3712  
NR

12/16 Spud 11-24-53 D & A TD 3902  
1954 8" @ ~~3497~~ 251 Anhy 2078 Heeb 3461'  
1/6 Lans. 3497'

DST 3499-3511, open 1 hr, rec 40' wtr.  
DST 3523-71, open 3/4 hr rec 15' free oil, 60' HOCM 235#  
B KC 3709' Cong. 3809' Gr. wash 3880' TD 3902 5" @ 3712  
CO to TD 12/3660-64 9/3623-26  
18/3596-3602 1000 A SSO SP 3580  
12/3558-62 SO & wtr. 9/3545-48  
Sq. 9/3545-58 wtr.  
D & A

**ABANDONED**

