


Section 17 Township 3 Range 25 W

Well No. # 1 Brooks

Company Anderson-Prichard

NORTH

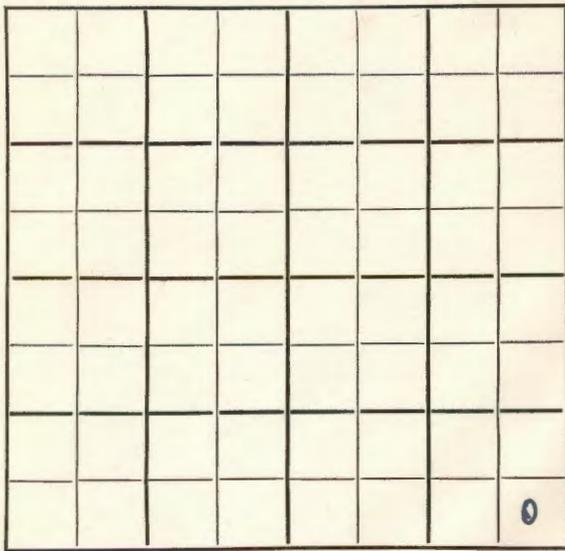

SOUTH

16

Sec. 17 Twp. 3 R. 25W

Well No. #1 Brooks Farm

Anderson-Prichard Company

Glen Peel

Wildcat

Contractor

Ft. from N. Line

330

Ft. from S. Line


330

Ft. from E. Line

Ft. from W. Line

SE SE SE

NORTH

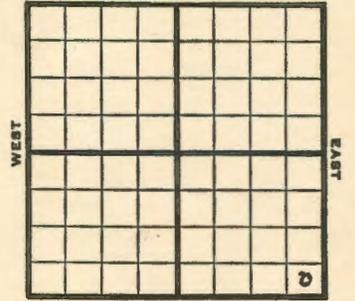

SOUTH

1953

Elev. 2481 IS

Elev. 2483 RB

REPORT

7/1

Spud 6-23-53  
8" @ 205'

Heeb 3425, Tor 3455, Lans 3468

DST 3459-90 opn 1 hr, rec 20' mud & SSO 832#

DST 3524-55 opn 1/2 hr, rec 8' mud & SSO 55# Drlg 3555'

7/8

Spud 6-23-53  
D & A

TD 3895'  
8" @ 205'

Heeb 3425, Tor 3455, Lans 3468.

DST 3459-90 opn 1 hr, rec 20' mud & SSO, 832#

DST 3524-55 opn 1/2 hr, rec 8' mud & SSO 55#

Schlumberger Tops: Anhy 2045, Top 3308, Heeb 3428, Lans 3468, B KC 3666

Basal Penn. 3784,

DST 3769-3803 opn 1/2 hr, rec 10' mud 140# Arb 3791, Regan 3872, Gr. Wash 3882.

TD 3895'  
D & A

ABANDONED

