


Section 27 Township 3 Range 25W

Well No. #1 Gray

Company Empire Drlg.

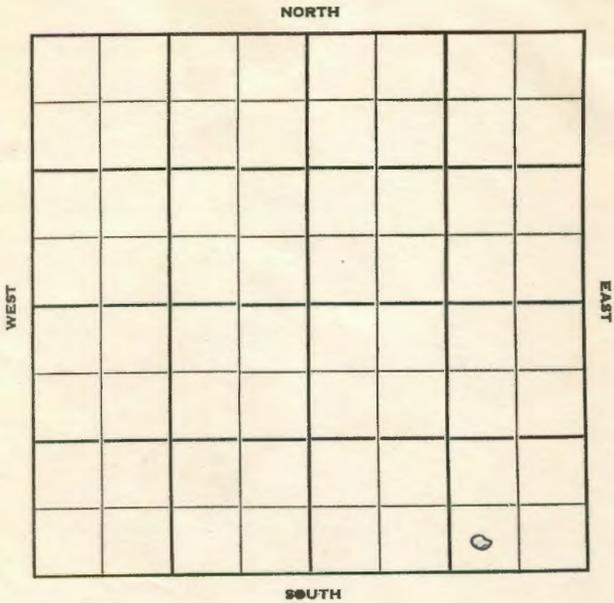

16

Sec. 27 Twp. 3 R. 25 W

Well No. # 1 Gray


Empire Drlg.

Wildcat  
Ft. from N. Line

330 Ft. from S. Line

990 Ft. from E. Line

Ft. from W. Line

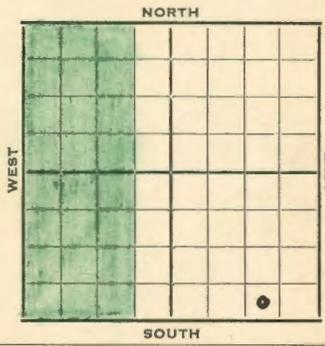

SW SE SE  
Skelly \$2,000 DHM  
MCPC has NW of 2-4-25W

1952 **Elev. 2383'** REPORT

- 7/23 Cellar & Pits
- 7/30 " "
- 8/6 " "
- 8/13 8" @ 181'
- 8/20 Anhy 1945' Topeka 3192'
- Heeb 3340' Tor 3370'
- Drlg. 3580'
- 8/27 Spud 8-11-52
- D&A TD 3875'
- 8" @ 181'
- Anhy 1945 Top. 3192
- Heeb. 3370 Tor. 3399
- Lans. 3413 B KC 3601
- Arb. 3721 Regan 3842
- Gr Wash 3849
- TD 3875' D&A


**ABANDONED**

County **Norton** State **Kansas**  
 Sec. **27** (Blk. **3** (Sur. **25W** Map No.  
 Operator **Empire Drlg.**  
 Well No. **1** Farm **Gray**  
 Elev. **2383** Location **SW SE SE**




**330** Ft. From **S** Line **SE**  
**990** Ft. From **E** Line **Quarter**  
 Ist. Report  
 Completion **JUL 27 1952**  
 Remarks **Wildcat**  
 Spudding Date **8-11-52**

Drlg. Data **D & A** **TD 3875**  
**8" @ 181** **Anhy 1945** **Top. 3192**  
**Heeb. 3370** **Tor. 3399** **Lans. 3413**  
**B KC 3601** **Arb. 3721** **Regan 3842**  
**Gr. wash 3849** **TD 3875**  
**D & A**

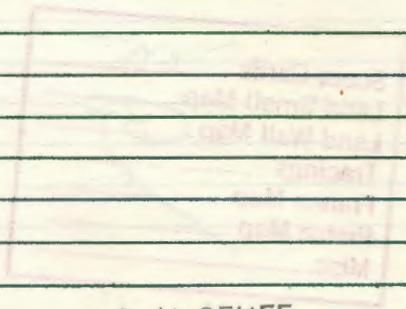

J. G. McGEHEE

County **Norton** State **Kansas**  
 Sec. **27** (Blk. **3** (Sur. **25W** Map No.  
 Operator **Empire Drlg.**  
 Well No. **1** Farm **Gray**  
 Elev. Location **SW SE SE**

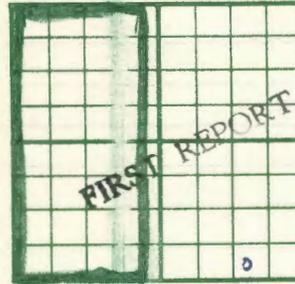

**350** Ft. From **S** Line **SE**  
**990** Ft. From **E** Line **Quarter**  
 Ist. Report **JUL 23 1952**  
 Completion  
 Remarks **Skelly \$2000**  
**MCPC has NW of 2-4-25W**  
 Spudding Date

Drlg. Data **Wildcat**  
**Cellar & pits**

J. G. McGEHEE