


Section 25 Township 3 Range 25W

Well No. 1 Humphrey

Company Trans-Era

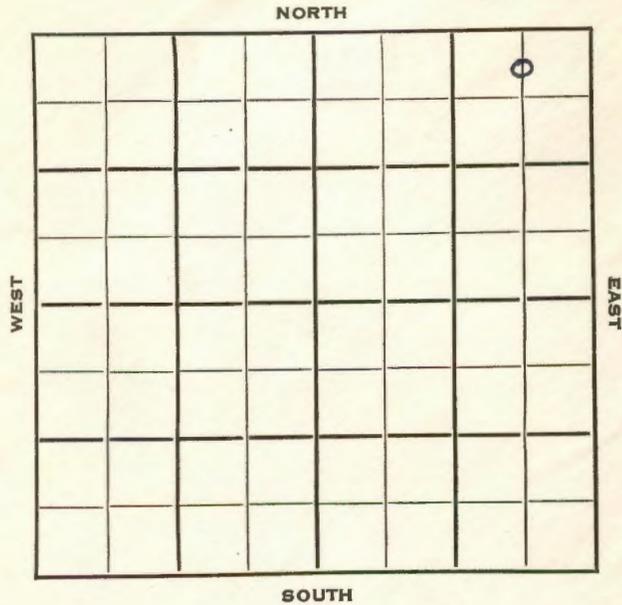

Norton

SEC. <u>25</u>	TWP. <u>3</u>	R. <u>25 W</u> ✓
----------------	---------------	------------------

WELL NO. # 1 Humphrey FARM

COMPANY Trans-Era

CONTRACTOR Trans-Era


Wildcat

330 Ft. from N. Line

\_\_\_\_\_ Ft. from S. Line

660 Ft. from E. Line

\_\_\_\_\_ Ft. from W. Line

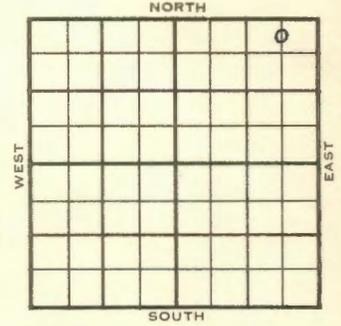

C N L N E N E

Continental-DHM

	ELEVATION	REPORT
<u>1954</u>	<u>2338'</u>	
<u>2/17</u>	Spud 2-14-54 8" @ 203' Drlg. 600'	
<u>2/24</u>	Spud 2-14-54 D&A TD 3730' 8" @ 203' <b>Heeb 3319', Lans 3366', Cong 3654', Regan 3682', Gr Wash 3700'</b> TD <b>3730'</b> D&A	

**ABANDONED**

