


Section 31 Township 3 Range 27W

Well No. 1 Frickey

Company Harry Gore

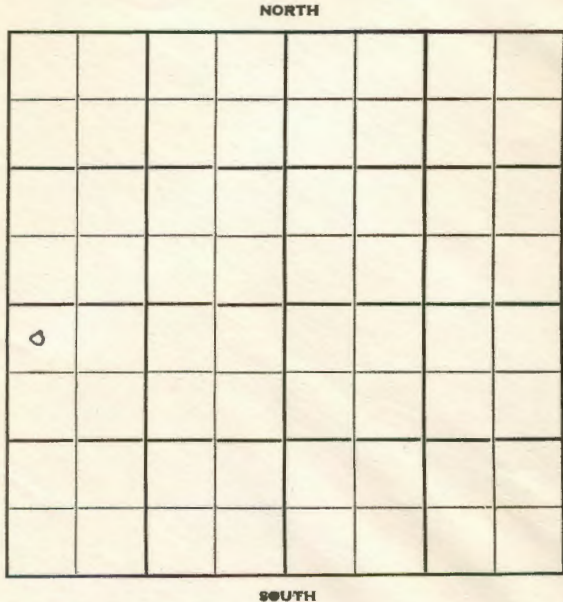

12

Sec 31 Twp. 3 R. 27 W

Well No. # 1 Frickey Farm

Harry Gore Company

Contractor

Wildcat


330 Ft. from N. Line

_____ Ft. from S. Line

_____ Ft. from E. Line

330 Ft. from W. Line

NW NW SW
Sinclair DHM

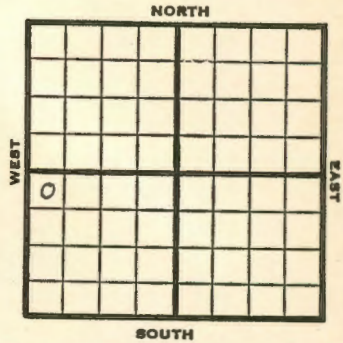

1951

Elev. 2690 REPORT

7/25

RUR

8/8

D&A TD 4355'
8-5/8" @ ?

Anhy 2428 Top 3515

Heeb. 3680 Dodge 3696

Lans. 3724

DST 3833-62" opn 25 min

Rec. 35' mud

Cong. 4181 Arb. 4315-55 TD

D&A

ABANDONED

