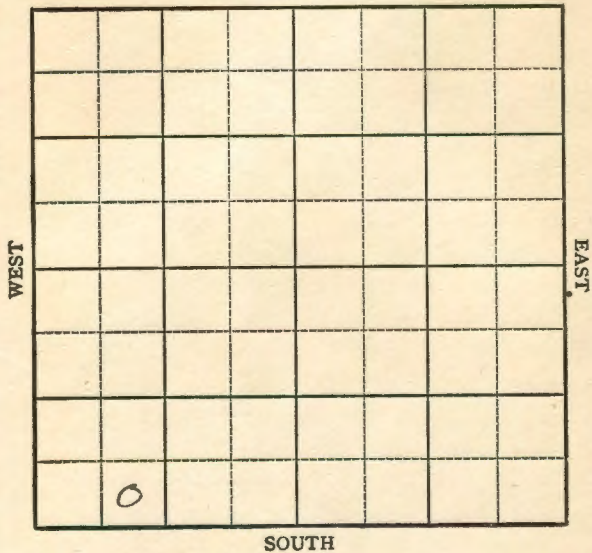


KANSAS

Decatur

Section 21 Township 3 Range 27WWell No. 1 BrownCompany A.J. StormfeldtWildcat  
NORTH

SOUTH

13

KANSAS

Decatur

Sec. 21 Twp. 3 R. 27W ✓Well No. #1 Brown FarmA. J. Stormfeldt Company

Wildcat


Ft. from N. Line

330' Ft. from S. Line

Ft. from E. Line

990' Ft. from W. Line

SE SW SW

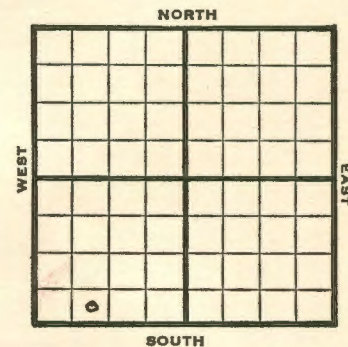

1948

Elev. 2599' REPORT

8/18

RUR

8/25

8" @ 301'

Drlg 1890'

9/1

Lansing 3544'

Drlg. 3595'

9/8

Arbuckle 4016'

TD 4075'

ABANDONED

Scout S. J. LEWIS

Scout **S. J. LEWIS**