


KANSAS CORPORATION COMMISSION

WELL RECORD

16-3-28W

(Mail to Kansas Geological Survey, 4150 Monroe Street, Wichita, Kansas 67209)

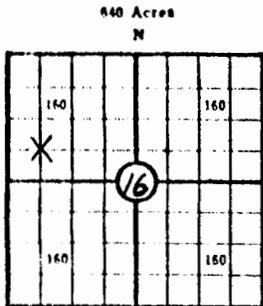

Lease Name: Bremer Well No. 1
 Well Located: C SW NW
SEC 16 TWP 3S RGE 28W
 Operator: Abercrombie Drilling, Inc.
 Address: 801 Union Center
 Elevation: Ground 2717 D.F. 2723 K.B. 2725
 Type Well: (Oil, gas, dry hole) Dry Hole

Drilling Commenced: December 30 1971 Drilling Completed: Jan. 6, 1972
 Well Completed: 19 Total Depth 3954'
 Initial Production: D&A

Casing Record

Size: 8-5/8" Set at 228' Size: _____ Set at _____
 Size: _____ Set at _____ Size: _____ Set at _____

Liner Record

Size: _____ Set from _____ To _____

Cementing

<u>Casing Size</u>	<u>Sacks</u>	<u>Type Cement and Additives</u>
<u>8-5/8"</u>	<u>150</u>	<u>Common</u>
_____	_____	_____
_____	_____	_____

Perforations

<u>Formation</u>	<u>Perforated Interval and Number Shots</u>
_____	_____
_____	_____
_____	_____
_____	_____

Electric Log Run (Show type log and depths covered)

Gamma Ray, Guard, Neutron, Caliper 2400-2500 3400-3956

Cont. 16-3-28w

Show Drill Stem Tests,
Well Stimulation and
Production Tests

Formation	Top	Bottom	
Lansing-K.C.	3749'	3765'	10" - 30" - 60" - 45" Recovered 785' muddy water IFP 0-43#, IBHP 1273# FFP 86-335#, FBHP 1262#. BHT 113°
Lansing-K.C.	3763'	3780'	30" - 30" - 30" - 45" Recovered 20' mud IFP 16-21#, IBHP 1107# FFP 42-42#, FBHP 1097. BHT 107°
Lansing-K.C.	3854'	3885'	10" - 30" - 60" - 45" Recovered 90' mud, 180' muddy water IFP 21-37#, IBHP 717# FFP 69-122#, FBHP 654#. BHT 124°

LOG TOPS	DEPTH
ANHY	2415
B ANHY	2447
HEEB	3694
TOR	3725
LKC	3735
RTD	3954
LTD	3956

