



5-3-29W P1

LEASE # WELL # AMANDA B-1  
FIELD: POLLHOW


LOCATION C W/2 - W/2 - NW/4 - 5-3S-29W  
Co. STATE DECATUR, KS

DATE 11/12/84  
D.R. FINIK

TOC WI \_\_\_\_\_ RI \_\_\_\_\_  
ELEV. GL \_\_\_\_\_ KB 2737 DF \_\_\_\_\_

DATE COMPLETED 8/21/68  
FORMATION L-KC  
INITIAL TREATMENT: 3758 1/2 - 3761 AW/250  
CRA, 750 157.  
3773 - 3776 AW/500 REG

WORKOVERS, STIMULATIONS, CHG IN PRODUCTION METHODS.

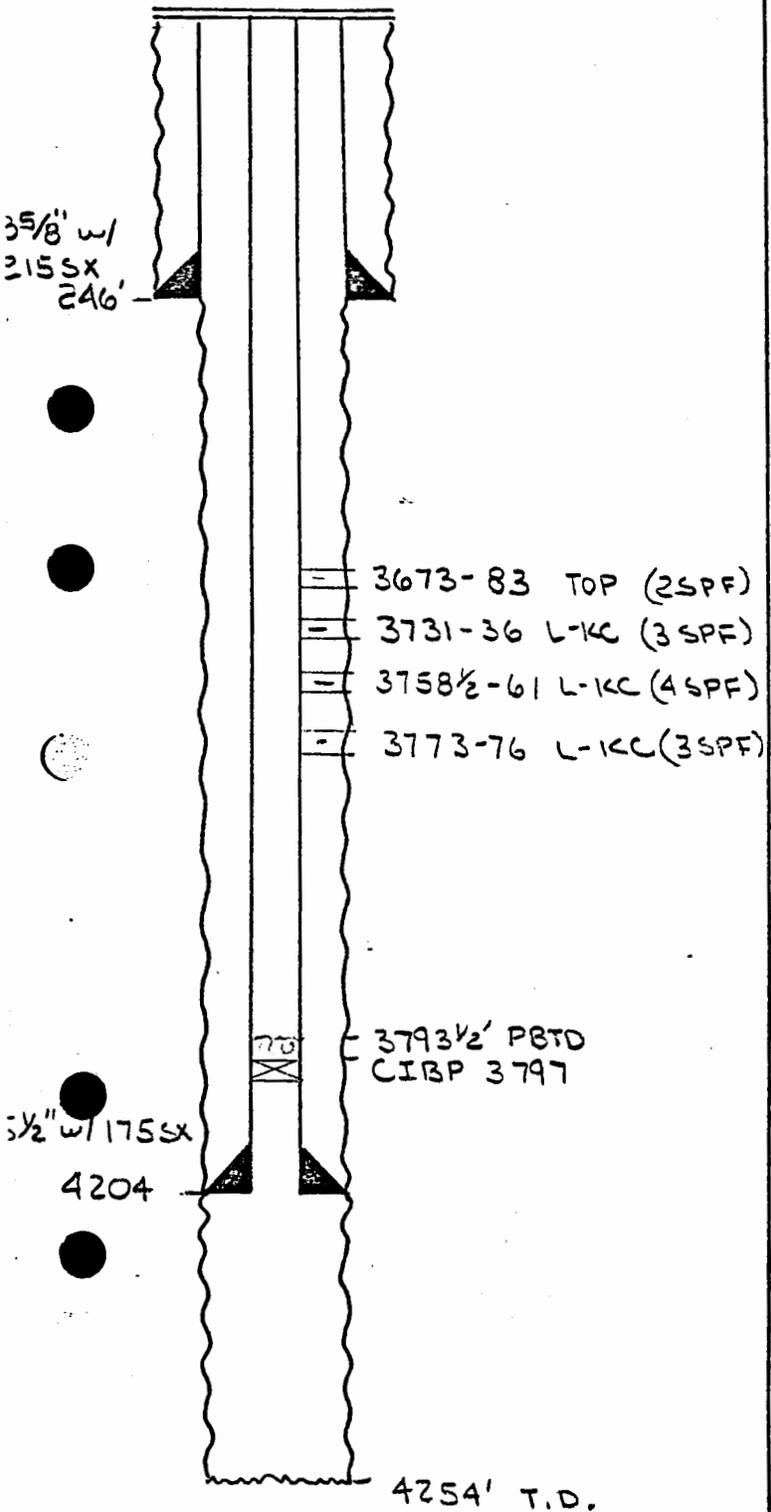

MAY 07 1985  
State Geological Survey  
WICHITA BRANCH

REMARKS.

RECEIVED  
STATE CORPORATION COMMISSION

MAY 06 1985

CONSERVATION DIVISION  
Wichita, Kansas

5-35-29w<sup>B1</sup>

Amanda B-1 Procedure

- 1) RIH w/cement retainer to 1900'.
- 2) Pump 270 sx 60/40 poz.
- 3) Sting out of retainer pull up to 400'.
- 4) Pump 200 sx 60/40 poz.
- 5) POH w/tbg.
- 6) Shoot off csg @ 400'.
- 7) Pump 200 sx 60/40 poz.
- 8) Weld on plate etc.

State Corporation Commission  
WICHITA BRANCH

RECEIVED  
STATE CORPORATION COMMISSION

MAY 06 1995

CONSERVATION DIVISION  
Wichita, Kansas