


6-3-29W P1

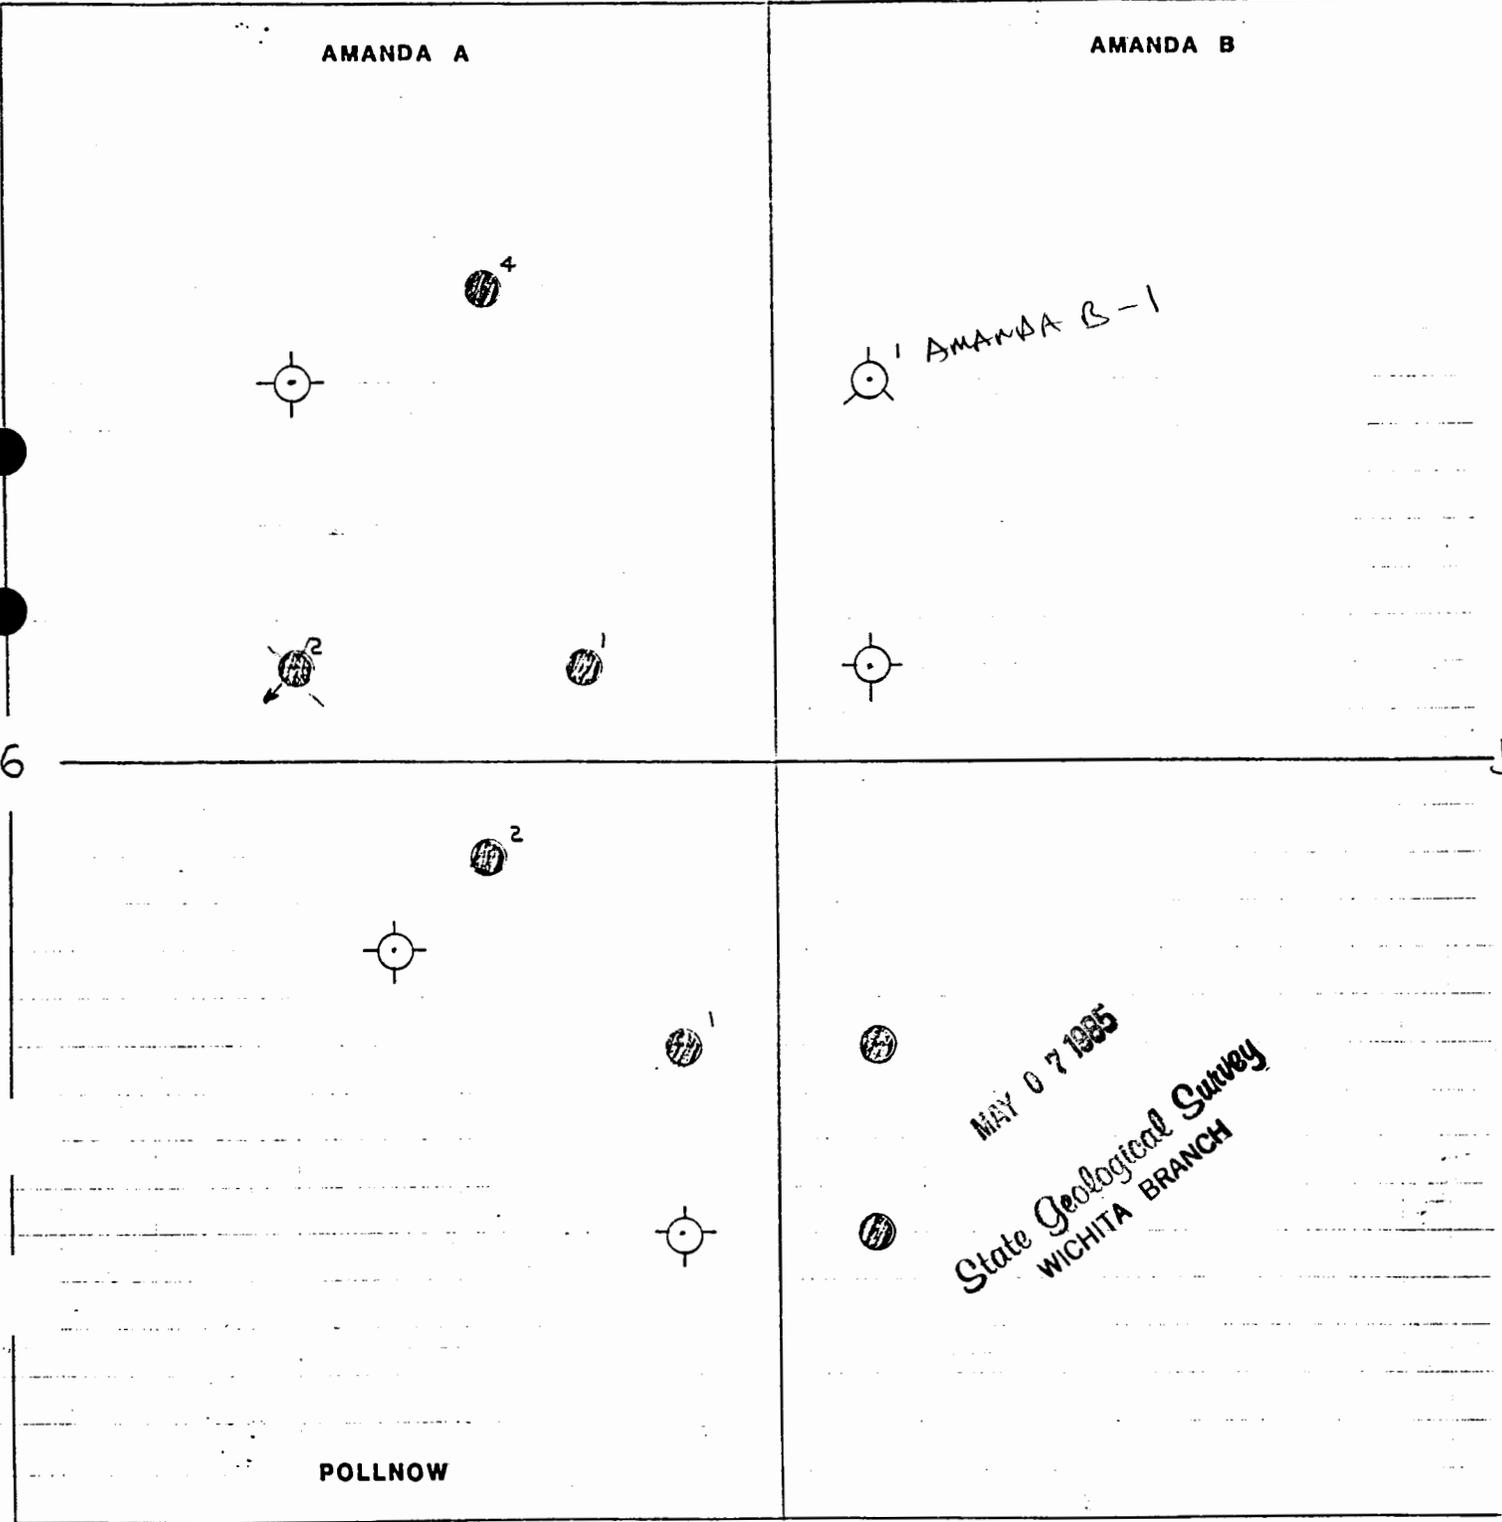

PRODUCING WELL



SWD



D&A

RECEIVED
STATE CORPORATION COMMISSION

MAY 06 1985

CONSERVATION DIVISION
Wichita, Kansas

D.R. FINK
11/12/84