WELL LOG BUREAU—KANSAS GEOLOGICAL SOCIETY
508 East Murdock, Wichita, Kansas


7-3-29W

Company. W. W. SAUVAGE
Farm. Larson No. 1

SEC. 7 T. 3 R. 29W
NE NE SE

County Decatur

KANSAS

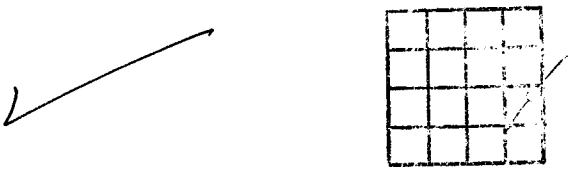

Total Depth. 4380
Comm. 12-16-53 Comp. 12-30-53
Shot or Treated.
Contractor. Sauvage Dunn Drlg.
Issued. 1-30-54

CASING:
8 5/8" 194 cem. w/150

Elevation. 2697 D.F.

Production. Dry

Figures Indicate Bottom of Formations.

cellar	5
shale & lime	1000
shale	1720
shale & lime	1750
shale & shells	2316
shale & lime	2510
red bed & shale	2535
anhyd. & redbed	2670
shale & shells	2695
lime & shale	4309
shale & lime	4380
Total Depth	

Tops:

Cimarron anhyd.	2227 (driller)
Topeka lime	3608
Heebner shale	3783
Toronto lime	3816
Lansing lime	3829
Base Kansas City	4037
Cherokee sdy cong.	4220
cherty cong.	4317
Arb. dolo.	4358

small show of tarry oil & black stain
no odor 3817-19
tarry oil & black stain. 3834-3839
spotted black st in 3859
tarry oil and black residual stain
3864-59
show of tarry oil & black
residual stain no odor. 3947-3951
black residual stain 3977-3982
small show of free tarry oil &
sp tted brown stain. no odor 3983-3990
T.D. 4380. No commercial shows.