


KANSAS CORPORATION COMMISSION

WELL RECORD

10-3-29W

API # 15-039-20,233

(Mail to Kansas Geological Survey, 4150 Monroe Street, Wichita, Kansas 67209)

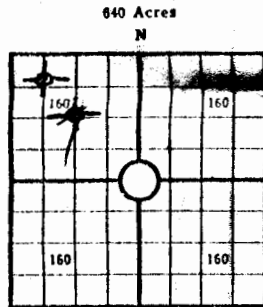

Locate well correctly

Lease Name: Zander Well No. 1
 Well Located: Approximate C NW NW (150' N of NW NW)
Decatur County SEC 10 TWP 3S RGE 29W
 Operator: Abercrombie Drilling, Inc.
 Address: 801 Union Center, Wichita, Kansas 67202
 Elevation: Ground 2661 D.F. 2667 K.B. 2669
 Type Well: (Oil, gas, dry hole) Dry Hole L-KC

Drilling Commenced: April 15, 1972 Drilling Completed: April 21, 1972
 Well Completed: April 21, 1972 Total Depth 3880'
 Initial Production: _____

Casing Record


Size: 8-5/8" Set at 237' Size: _____ Set at _____
 Size: _____ Set at _____ Size: _____ Set at _____

Liner Record

Size: _____ Set from _____ To _____

Cementing

Casing Size	Sacks	Type Cement and Additives
<u>8-5/8"</u>	<u>150</u>	<u>Common cement</u>
_____	_____	_____
_____	_____	_____

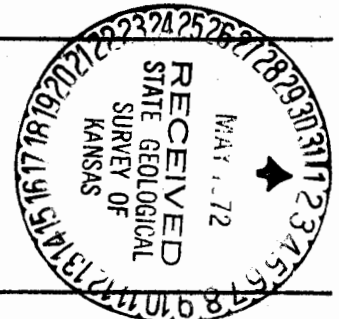PerforationsFormationPerforated Interval and Number Shots

Formation	Perforated Interval	Number Shots
_____	_____	_____
_____	_____	_____
_____	_____	_____


Electric Log Run (Show type log and depths covered)

None

Cont 10-3-29w

Show Drill Stem Tests,
Well Stimulation and
Production Tests

Formation	Top	Bottom	
Lansing & Toronto	3643	3685	30" - 30" - 30" - 30" Recovered 5' mud. IFP 21-21#, IBHP 92#, FFP 32-32#, FBHP 75#.
Lansing	3695	3711	20" - 45" - 30" - 45" Recovered 5' mud IFP 10-10#, IBHP 10#, FFP 10-10#, FBHP 10#.

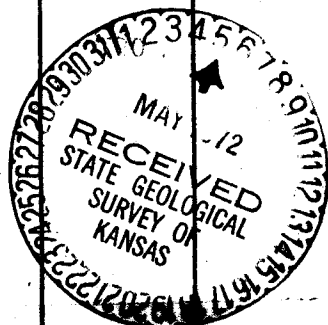

0	90	Clay
90	120	Sand & Gravel
120	1650	Shale
1650	1798	Sand
1798	2123	Shale
2123	2142	Anhydrite
2142	2391	Shale
2391	2424	Anhydrite
2424	2530	Shale
2530	2800	Shale & Lime
2800	3130	Lime and Shale
3130	3223	Lime
3223	3365	Lime and Shale
3365	3880	Lime
	3880	Rotary Total Depth

Drilled 239' of 12 1/4" surface hole and set 8-5/8" csg. at 237' K.B. cemented w/150
sx. Sunset cement. Cement circulated. Plug was down at 2:00 p.m. 4-15-72.
Dry and Abandoned

SAMPLE TOPS

Anhydrite	2391 (+ 278)
B/Anhydrite	2424 (+ 245)
Heebner	3642 (- 973)
Toronto	3671 (-1002)
Lansing	3681 (-1012)
Total Depth	3880 (-1211)

Requet

VI 12 12 24 20 100

10-3-29w