

Section 3 Township 3 Range 29W

Sec. 3 Twp. 3 R. 29 W

Well No. 1 Nitsch

Well No. # 1 Nitsch Farm

Company Anderson-Prichard

Anderson-Prichard Company

Glenn Peel Contractor

Wildcat



Ft. from N. Line

330 Ft. from S. Line

330 Ft. from E. Line

Ft. from W. Line

SE SE SE
Sunray - DHM

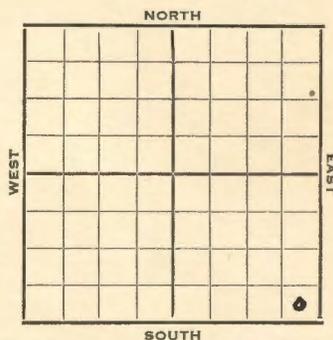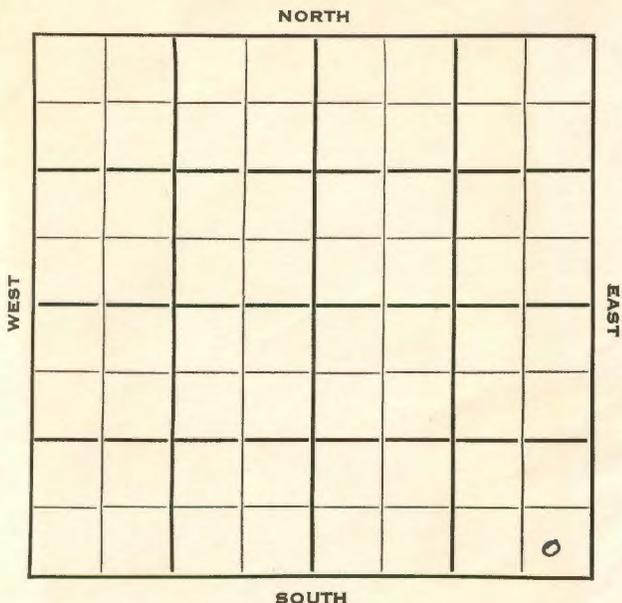

16

1953 **Elev. 2619'** REPORT

4/8 Spud 4-4-53
8" @ 190
Drlg. 1923'

4/16 **Heeb 3593, Tor 3624, Lans 3634**
DST 3649-62, 1/2 hrs., 6' M
DST 3670-77, 1/2 hr., 6' M
Drlg. 3881'

4/22 Spud 4-4-53
D & A TD 4188' 8" @ 190
Heeb 3591 Tor. 3621 Lans 3633'
DST 3649-62, open 1/2 hr, rec 6' mud O#
DST 3670-77 open 1/2 hr, rec 6' mud O#
Arb. 4144' TD 4188'
D & A

ABANDONED

