


Decatur

KANSAS

SECTION 4 TOWNSHIP 3 S RANGE 29 W

WELL NO. # 2 Lotker

COMPANY Anderson-Prichard

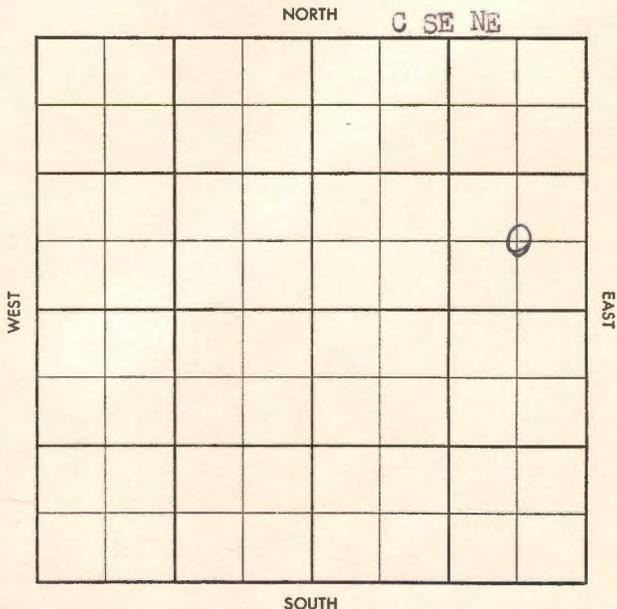

8

X
X
X
X

Twp. X Pool X
Co. X Facet X

S-513-B

S-513-B

County Decatur Elev. _____
 Sec. 4 Twp. 3 Rge. 29W
 Company Anderson-Prichard
 Farm Name Lotker No. 2

County Decatur Elev. _____
 Sec. _____ Twp. 3 Rge. 29W
 Company Anderson-Prichard
 Farm Name Lotker No. 2

TOPS	DEPTH	LOG	DATUM	Loc. in Sec.
Anh.				<u>C SE NE</u>
Tp.				
H.				
Tr.				
Dg.				
B.L.				
L.				
K.C.				Geol. _____
B.K.C.				Contr. <u>Glenn Peel</u>
Ce.				Pool <u>Pollnow</u>
C.				
M.				
M.				
K.				
Mz.				
Mq.				
V.				
S.				
S.				
A.				
R.				
Pf.				
G.				
T.D.				

TOPS	DEPTH	LOG	DATUM	Loc. in Sec.
Anh.				<u>C SE NE</u>
Tp.				
H.	<u>3657</u>			
Tr.	<u>3690</u>			
Dg.				
B.L.				
L.	<u>3700</u>			
K.C.				Geol. _____
B.K.C.	<u>3906</u>			Contr. <u>Glenn Peel</u>
Ce.				Pool <u>Pollnow</u>
C.				
M.				
M.				
K.				
Mz.				
Mq.				
V.				
S.				
S.				
A.				
R.				
Pf.				
G.				
T.D.	<u>3913</u>			

FIRST REPORT
 JUL 29 '58

ABANDONE
 JUL 30 '58

Date Comm. _____
 Location MI

Date Comm. 7-21-58 8' 226/125
 Location MI JUL 40 '58 DST 3712-27
1hr 8' M BHP 0/20 DST 3724
-50 30" 2'M BHP 0/20"
log

D-6A