


Section 4 Township 3 Range 29W

Well No. #1 Pollnow

Company Anderson-Prichard

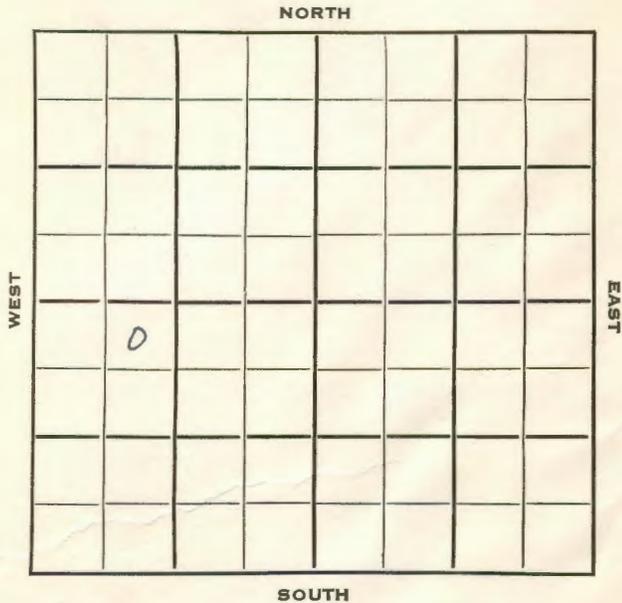

12

Sec. 4 Twp. 3 R. 29W

Well No. #1 Pollnow Farm

Anderson-Prichard Company

Peel Drlg. Contractor

Wildcat


330 Ft. from N. Line

Ft. from S. Line

Ft. from E. Line

990 Ft. from W. Line

NE NW SW
Ashland Support

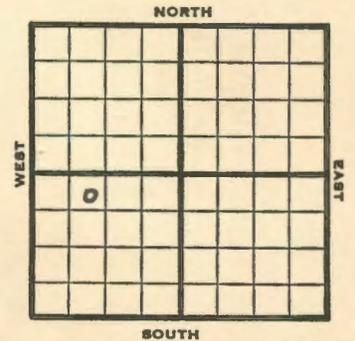

1953 Elev. 2701' REPORT

3/25 TITE HOLE
Drlg.

4/2 Drilling

4/9 "

4/16 "

4/23 "

4/30 NR

5/7 NR

5/13 Spud 3-19-53
Oil Well
TD 4406'
8" @ 195'

Heeb 3668, Tor 3698,
DST 3612-60 opn 1 hr, rec 75' mud, 1140
DST 3666-3726 opn 1 hr, rec 935' SW
1230# Lans 3710,
DST 3733-60 opn 3/4 hr, rec 710' oil
100' hocm, 1050#
DST 3768-93 opn 1/2 hr, rec 7' mud 0#
DST 3806-62 opn 1 hr, rec 4' oil, 33'
hocm 900#
DST 3872-3905 opn 1 hr, rec 60' ocm,
165# B KC 3914, Cong 4096,
DST 4086-4140, opn 1 hr, rec 1530' mudd
SW 1010# Arb 4190.

OVER

1953

Information brought forward

5/13 DST 4185-95 opn $\frac{1}{2}$ hr, rec 9' mud, 765#
Regan 4371, Gra. 4397,
TD 4406'
5" @ 3961'
CO to 3927
6/3720-22 10 bwph CO to 3927
54/ 3886-95 PB 3877 30/ 3858-63
S/ 8 gwph & SO 250 A S/ 15 bwph
PB 3848 12/ 3720-22 wtr.
CO to 3848
42/ 3734-41 S/ 48 bo 16 hr.
Comp. 79 bopd.

COMPLETED

