

Section 4 Township 3 Range 29W

Well No. #1 Pollnow


Company Ashland Oil & Ref.

SEC. 4 TWP. 3 R. 29 W

WELL NO. # 1 Pollnow FARM

COMPANY Ashland Oil & Ref.

CONTRACTOR Hannum Drlg.

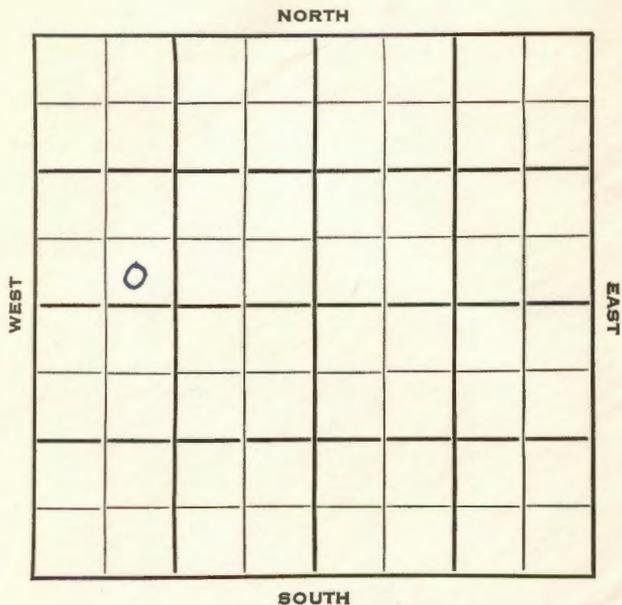


\_\_\_\_\_ Ft. from N. Line

330 \_\_\_\_\_ Ft. from S. Line

\_\_\_\_\_ Ft. from E. Line

990 \_\_\_\_\_ Ft. from W. Line

SE SW NW

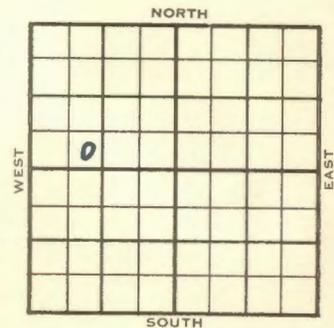

1953 ELEVATION Elev. 2700' REPORT

9/23 RUR

9/30 8" @ 200' w/150 sks  
Anhy 2394'  
Drlg 3205'

10/7 Spud 9-22-53 D & A TD 3950'  
8" @ 200 Anhy 2394' Top 3562'  
Heeb 3662' Lans 3705'  
DST 3705-13 open 1 hr, rec 400' SW  
1170#  
DST 3731-40 open 1½ hr rec 20' VSOCM  
0#  
DST 3753-86 open 1 hr rec 90' mud  
B KC 3925' TD 3950'  
D & A

**ABANDONED**


5

County Decatur State Kansas  
 Sec. 4 (Blk. 3 (Sur. 29W Map No.  
 Operator Ashland Oil & Ref.  
 Well No. 1 Farm Pollnow  
 Elev. 2700 Location SE SW NW




330 Ft. From S Line NW  
990 Ft. From W Line Quarter  
 Ist. Report  
 Completion OCT 7 1953  
 Remarks  
Hannum Drlg. - Contr.  
 Spudding Date 9-22-53

Drlg. Data D & A TD 3950  
8" @ 200 Anhy 2394 Top. 3562  
Heeb. 3662 Lans. 3705 DST 3705-13  
open 1 hr. Rec. 400' sw 1170#  
DST 3731-40 open 1 1/2 hr. Rec. 20' vsocm  
0# DST 3753-86 open 1 hr. Rec. 90' mud  
B KC 3925 TD 3950

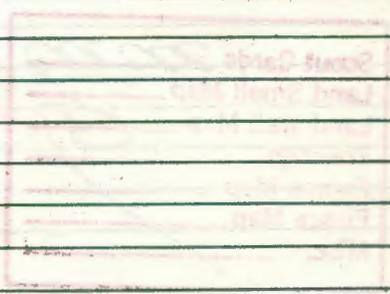

J. G. McGEHEE

County Decatur State Kansas  
 Sec. 4 (Blk. 3 (Sur. 29W Map No.  
 Operator Ashland Oil & Ref.  
 Well No. 1 Farm Pollnow  
 Elev. Location SE SW NW

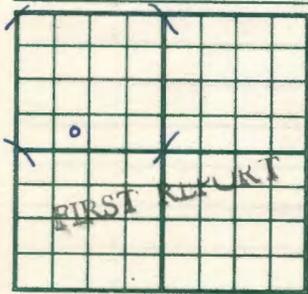

330 Ft. From S Line NW  
990 Ft. From W Line Quarter  
 Ist. Report SEP 23 1953  
 Completion  
 Remarks  
Hannum Drlg. - Contr.  
 Spudding Date

Drlg. Data  
RUR

J. G. McGEHEE