


Section 4 Township 3 Range 29 W

Well No. #2 Pollnow

Company Anderson-Prichard

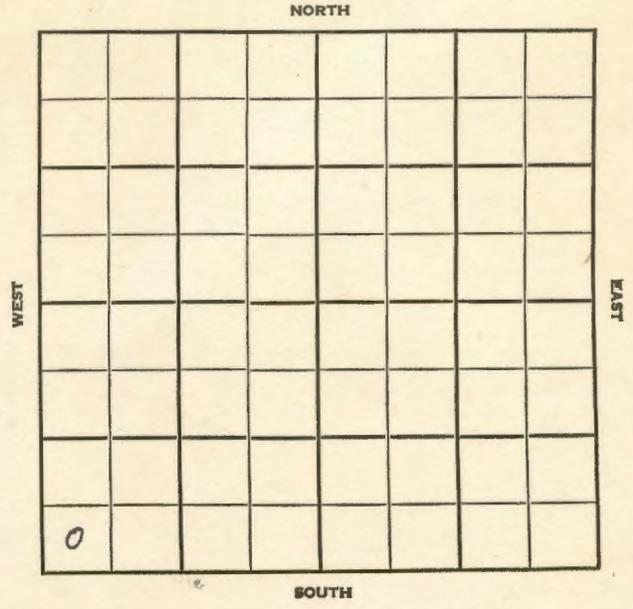

13

SEC. 4	TWP. 3	R. 29W
--------	--------	--------

WELL NO. #2 Pollnow

FARM

COMPANY Anderson-Prichard

CONTRACTOR Sauvage

Pollnow


\_\_\_\_\_ Ft. from N. Line

\_\_\_\_\_ Ft. from S. Line

\_\_\_\_\_ Ft. from E. Line

\_\_\_\_\_ Ft. from W. Line

SW SW SW

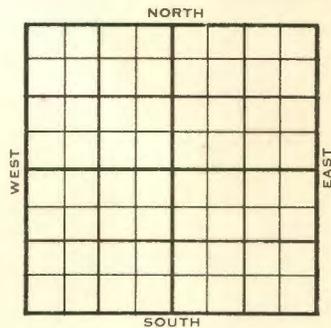

1955	ELEVATION 2697'	REPORT
------	-----------------	--------

7/27 Comp. 5-2-55  
 8" @202 DST 3732 open 1 hr. Rec. 840'  
 gas 670' 555/20" DST 3753-3873 open 1  
 hr. Rec. 10' drlg. mud 60/15" 5" @  
 3939/125 CO to 3913 7/3722-23 4/3723/  
 24 1/2 CO to 3917 32/3737-41 S/6 boph 12  
 hr. P/66 bo 12 hr. Comp. 105 bopd.  
 H. 3668 971  
 Tr. 3702 1005  
 L. 3710 1013  
 TD 3939

FIRST REPORT

COMPLETED

County Decatur Elev. 2697

Sec. 4 Twp. 3 Rge. 29W

Company Anderson-Prichard

Farm Name Pollnow No. 2

TOPS	DEPTH	LOG	DATUM	Loc. in Sec.
Anh.				SW SW SW
Tp.				
H.	3668		971	
Tr.	3702		1005	
Dg.				
Bl.				
L.	3710		1013	
K.C.				Geol.
B.K.C.				Contr
Ce.				Sauvage
C.				
M.				Pool
M.				Pollnow
K.				
Mz.				
Me.				
V.				
S.				
S.				
A.				
R.				
Pf.				
G.				
TD	3939			

FIRST REPORT COMPLETE

Date Comm. 5-2-55- JUL 27 1955

8" @ 202 BST 3732-50 open 1 hr.

Rec. 840' gas 670' oil 555/20"

DST 3753-3873 open 1 hr. Rec. 10'

drlg. mud 60/15" 5" @ 3939/125

CO to 3913 7/3722-23 4/3723-24

CO to 3917 32/3737-41 S/6 boph 12 hr

P/66 bo 12 hr. Comp. 105 bopd

32