


Decatur

KANSAS

SECTION 4 TOWNSHIP 3S RANGE 29W

WELL NO. #3 Pollnow

COMPANY Anderson Pritchard

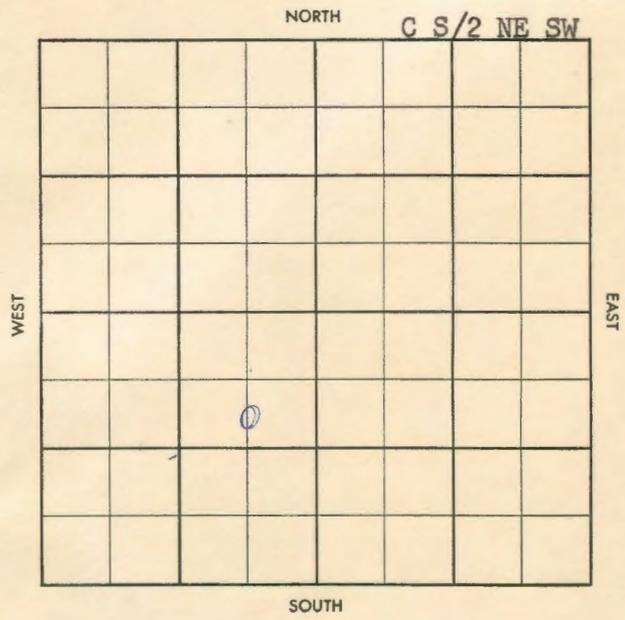

||

Top ~~X~~ Pool ~~X~~
 Co. ~~X~~ Facet ~~X~~

Top ~~X~~ Pool ~~X~~
 Co. ~~X~~ Facet ~~X~~

5-513-B

County Decatur Elev. _____
 Sec. 4- Twp. 3 Rge. 29W
 Company Anderson-Pritchard
 Farm Name Pollnow No. 3

TOPS	DEPTH	LOG	DATUM	Loc. in Sec.
Anh.				C S/2 NE SW
Tp.				
H.				
Tr.				
Dg.				
B.L.				
L.				
K.C.				Geol.
B.K.C.				Contr. <u>Peel Bros #3</u>
Ce.				Pool <u>Pollnow</u>
C.				<div style="border: 1px solid black; padding: 5px; transform: rotate(-45deg); display: inline-block;"> APR 2 1958 PAST REPORT </div>
M.				
M.				
K.				
Mz.				
Mq.				
V.				
S.				
S.				
A.				
R.				
Pf.				
G.				
T.D.				

Date Comm. C & P

5-513-B

County Decatur Elev. 2688 DE 2674 DE
 Sec. 4- Twp. 3 Rge. 29W
 Company Anderson-Pritchard
 Farm Name Pollnow No. 3

TOPS	DEPTH	LOG	DATUM	Loc. in Sec.
Anh.	<u>2150</u>			C S/2 NE SW
Tp.				
H.	<u>3653</u>			
Tr.	<u>3683</u>			
Dg.				
B.L.				
L.	<u>3696</u>			Geol.
K.C.				Contr. <u>Peel Bros #3</u>
B.K.C.	<u>3918</u>			Pool <u>Pollnow</u>
Ce.				<div style="border: 1px solid black; padding: 5px; text-align: center;"> COMPLETE APR 30 58 </div>
C.				
M.				
M.				
K.				
Mz.				
Mq.				
V.				
S.				
S.				
A.				
R.				
Pf.				
G.				
T.D.	<u>3925</u>			

Date Comm. 4-2-58
C & P

8" 224/175 78455
APR 15 58 DST 3714-30 8" 60" 120' gip
48' oil 20' HOCM BHP 305 SP25-45
5 1/2" 3856/125 woc APR 23 58 CO M 59
shoe 10/3719-23 1/4" 6 BF 85%
new oil 2 hrs pop APR 30 58 P 66
Bopd .490 w
Log 3719-23
 Ⓢ