


Decatur **KANSAS**Section 5 Township 3 Range 29WWell No. 1 Amanda PollnowCompany Franco-Central

NORTH

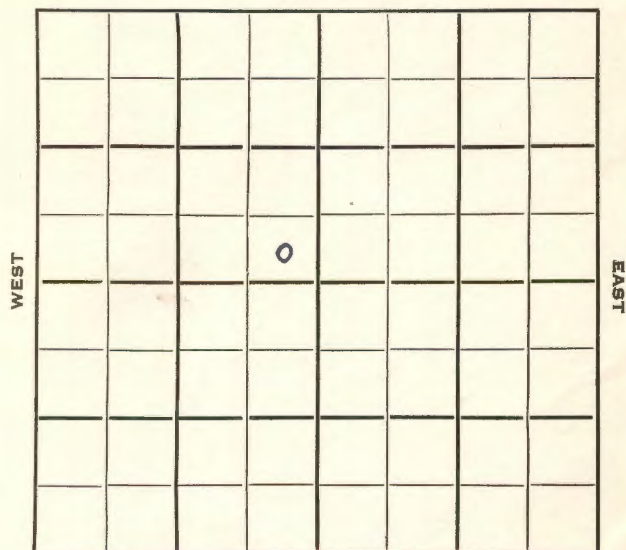

SOUTH

6

Decatur

KANSASSEC. 5 TWP. 3 R. 29W ✓

WELL NO.

#1 Amanda Pollnow

FARM

COMPANY

Franco-Central

CONTRACTOR

Sauvage

W. Pollnow Pool

NORTH

Ft. from N. Line

330


Ft. from S. Line

330

Ft. from E. Line

Ft. from W. Line

WEST

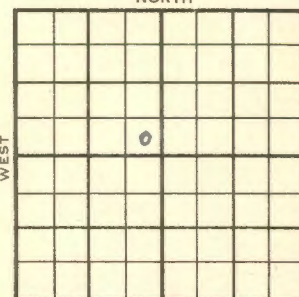

SOUTH

SE SE NW

1953

ELEVATION

2719'

REPORT

10/28

M I RT

11/4

Drlg. 3490'

11/11

Heeb 3683' Br 11 3708' Lans 3722'

DST 3747-55, 1 hr, 1230' GCO 600#

RTD 3938' 5" @ 3938'

11/18

Log 16/3733-34 wtr. & M Sq.

12/2

Spud 10-27-53

Oil Well

TD 3938'

8" @ 215'

Heeb 3683', Br line 3708', Lans 3722'

DST 3747-55', opn 1 hr., rec. 1230'

gco, 600#

TD 3938'

5" @ 3938

16/3733-34, wtr & mud

16/3747-52,

P/5 boph

Comp. 120 bopd

COMPLETED


County Decatur State Kansas

Sec. 5 (Blk. 3 (Sur. Rge. 29W Map No.)

Operator Franco-Central

Well No. 1 Farm Amanda Pollnow

Elev. 2719 Location SE SE NW

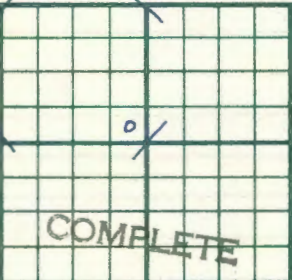

330 Ft. From S Line NW

330 Ft. From E Line Quarter

1st. Report

Completion DEC 2 1953

Remarks W. Pollnow Pool

Sauvage - Contr.

Spudding Date 10-27-53

Drig. Data Oil well TD 3938

8" @ 215 Heeb. 3683 Br. lime 3708

Lens. 3722 DST 3747-55 open 1 hr.

Rec. 1230' gco 600# TD 3938

5" @ 3938 16/ 3733-34 wtr & mud

16// 3747-52 P/ 5 boph Comp. 120 bopd

J. G. McGEHEE

County **Decatur** State **Kansas**

Sec. **5** (Blk.) **3** (Sur.) **29W** Map No.

Operator **Franco-Central**

Well No. **1** Farm **Amerida Pollnow**

Elev. Location **SE SE NW**

330 Ft. From **8** Line **NW**

330 Ft. From **E** Line Quarter

1st. Report **OCT 28 1953**

Completion

Remarks **Sauvage - Contr.**

Spudding Date

Drig. Data **W. Pollnow Pool**

IRT

J. G. McGEHEE