


Section 5 Township 3 Range 29W

Well No. 1 Pollnow "B"

Company Anderson-Pritchard

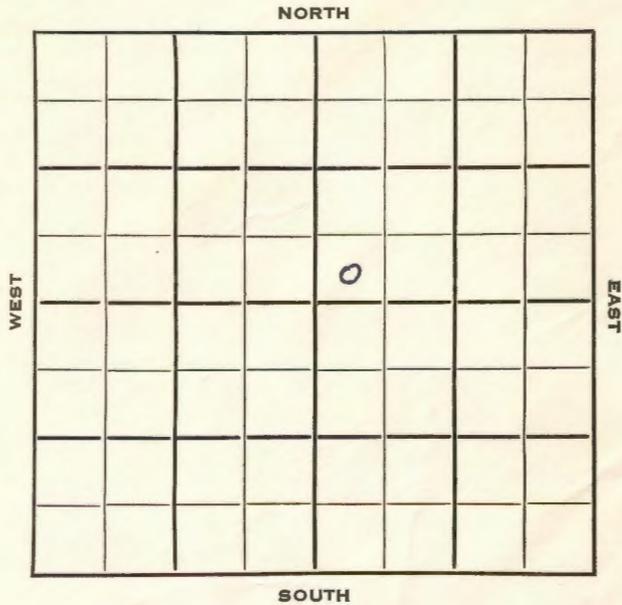

7

SEC.	TWP.	R.
<u>5</u>	<u>3</u>	<u>29W</u> ✓

WELL NO.

1 Pollnow "B"

FARM

COMPANY

Anderson-Pritchard

CONTRACTOR


Peel

\_\_\_\_\_ Ft. from N. Line

330 \_\_\_\_\_ Ft. from S. Line

\_\_\_\_\_ Ft. from E. Line

330 \_\_\_\_\_ Ft. from W. Line

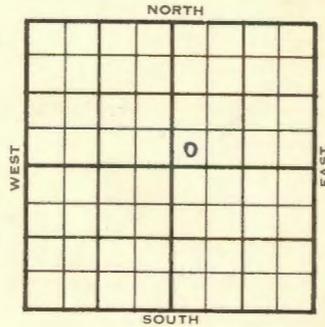

SW SW NE

1953	ELEVATION <u>2691'</u>	REPORT
------	---------------------------	--------

12/9 MIR

12/16 8" @ 201'  
Drlg. 2410'

1954  
1/27 Spud 12-12-53 Oil well TD 3928'  
8" @ 201 Heeb 3647' Tor. 3678  
Lans. 3694

DST 3682-94 open 1/2 hr rec 5' mud  
730#

DST 3708-23, open 1/2 hr rec 90' oil,  
60' MCO 1000# TD 3928' 5" @ 3919  
CO to 3928 16/3699-3701 CO to 3705  
48/3719-25 S/49 BO 8 hr.  
P/145 BO 24 hrs.  
Comp. 145 BOPD

**COMPLETED**

