


Section 5 Township 3 Range 29W

Well No. #2 Boettger

Company Anderson-Prichard

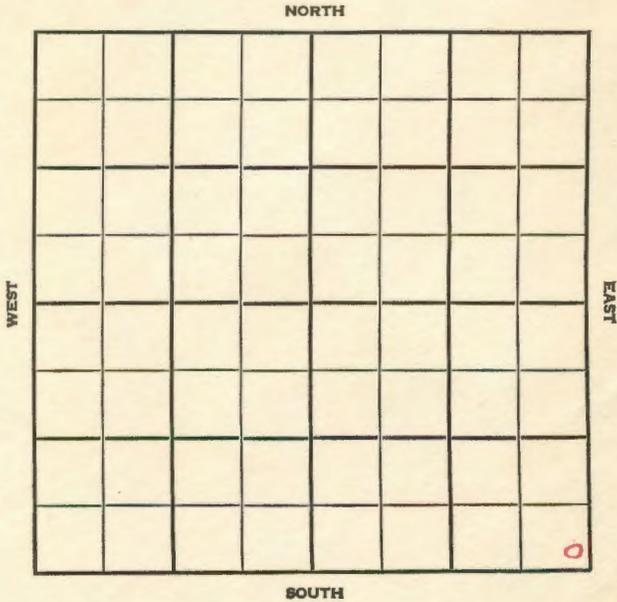

6

SEC.	TWP.	R.
<u>5</u>	<u>3</u>	<u>29W</u>

WELL NO. 2 Boettger FARM

COMPANY Anderson Prichard

CONTRACTOR Sauvage


Pollnow

\_\_\_\_\_ Ft. from N. Line

\_\_\_\_\_ Ft. from S. Line

\_\_\_\_\_ Ft. from E. Line

\_\_\_\_\_ Ft. from W. Line

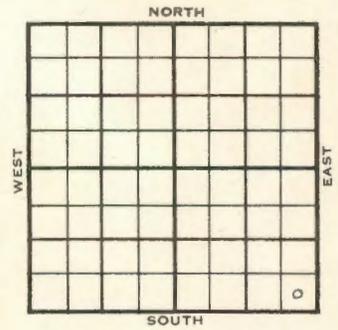

SE SE SE

1955	ELEVATION <u>2704'</u>	REPORT
------	------------------------	--------

5/26 Comm 5-14-55  
8" @ 215 w/100  
Drlg 1945

7/27 DST 3733-45 open 1 hr. Rec. 560' oil  
580/20" 5 1/2" @3939/75 CO to 3905 27/37  
43-48 S/4.7 bo 1 hr. S/17 bo 4 hr. P/  
63 bo 12 hr. P/109 bo 24 hr. Comp. 99  
bopd

H.	3671	967
Tr.	3702	998
L.	3711	1007
TD.	3940	

COMPLETED

County Decatur Elev. 2704  
 Sec. 5- Twp. 3 Rge. 29W  
 Company Anderson-Prichard  
 Farm Name Boettger No. 2

TOPS	DEPTH	LOG	DATUM	Loc. in Sec.
Anh.				SE SE SE
TP.				
H.	3671		967	
Tr.	3742		998	
Dg.				
Bl.				
L.	3711		1007	
K.C.				Geol.
B.K.C.				Contr.
Ce.				Sauvage
C.				
M.				Pool
M.				Pollnow
K.				
Mz.				
Me.				
V.				
S.				
S.				
A.				
R.				
PE.				
G.				
TD.	3940			

COMPLETE

Date Comm. 5-14-55 JUL 27 1955  
8" @ 215/100 DST 3733-45 open 1 hr.  
Rec. 560' oil 580/20" 5 1/2" @ 3939/75  
CO to 3905 27/ 3743-48 S/ 4.7 bo 1 hr.  
S/ 17 bo 4 hr. P/ 63 bo 12 hr.  
P/ 109 bo 24 hr. Comp. 99 bopd

Top Pool  
 Dr. Foot

FIRST REPORT

County Decatur Elev. \_\_\_\_\_  
 Sec. 5 Twp. 3 Rge. 29W  
 Company Anderson-Prichard  
 Farm Name Boettger No. 2

TOPS	DEPTH	LOG	DATUM	Loc. in Sec.
Anh.				SE SE SE
TP.				
H.				
Tr.				
Dg.				
Bl.				
L.				
K.C.				Geol.
B.K.C.				Contr.
Ce.				Sauvage
C.				
M.				Pool
M.				Pollnow
K.				
Mz.				
Me.				
V.				
S.				
S.				
A.				
R.				
PE.				
G.				
TD.				

Date Comm. 5-14-55  
8" @ 215 w/ 100 drlg. 1945

K-33