


Section 5 Township 3 Range 29W

Well No. 2 Pollnow

Company Franco-Central

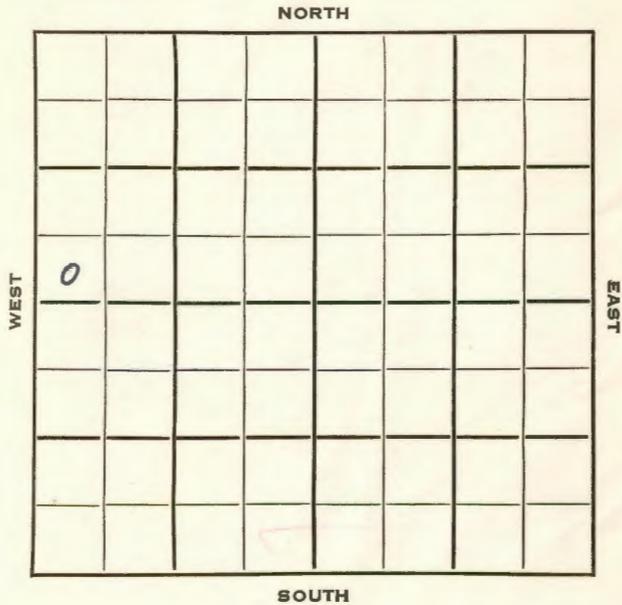

Decatur KANSAS

SEC. 5 TWP. 3 R. 29 W ✓

WELL NO. # 2 Pollnow FARM

COMPANY Franco-Central

CONTRACTOR Sauvage

Pollnow Pool

\_\_\_\_\_ Ft. from N. Line

330 \_\_\_\_\_ Ft. from S. Line

\_\_\_\_\_ Ft. from E. Line

330 \_\_\_\_\_ Ft. from W. Line

SW SW NW  
Sunray DHM

	ELEVATION	REPORT
1954	2740'	
1/13		Spud 1-8-54 8" @ 223 Drlg. 2500'
1/20		Br li 3721', Lans 3733' DST 3733-39', 3/4 hrs., 1' oil, 17' ocm, 800# DST 3758-65', 3/4 hrs., 5' oil, 30' ocm, 90# B KC 3941' RTD 3950' 5" @ 3946'
1/27		CO 3878' 32/3814-18 500 A SO & W SP 3788 48/3758-64 500 A Sq.
2/3		CO 8/3728-29 Sq. CO 48/3758-64 500 A 14 GOPH 1000 A
2/10		Spud 1-8-54 D & A TD 3950' 8" @ 223 Br. lime 3721 Lans 3733 DST 3733-39 open 3/4 hr, rec 1' oil 17' OCM 800# DST 3758-65, open 3/4 hr, rec 5' oil 30' OCM 90# B KC 3941' TD 3950 5" @ 3946 CO to 3878 32/3814-18 500 A SO & W SP 3788 48/3758-64 500 A 18/3728-29 48/3758-64 500 A 14 GOPH 1000 A 30/3733-38 500 A 3 GOPH 24 GW D & A <b>ABANDONED</b>

