
FORM 51

Decateur KANSAS

Section 7 Township 3 Range 29 W

Well No. # 1 Larson

Company W. W. Sauvage

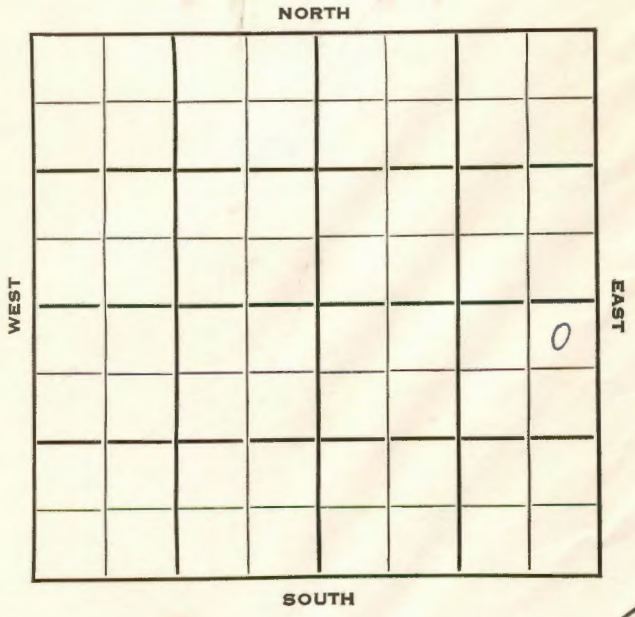

9

~~Edwards~~ KANSAS

SEC.	TWP.	R.
7	3	29W

WELL NO. 1 Larson FARM

COMPANY W. W. Sauvage


CONTRACTOR Sauvage-Dunn Wildcat

330 Ft. from N. Line

Ft. from S. Line

330 Ft. from E. Line

Ft. from W. Line

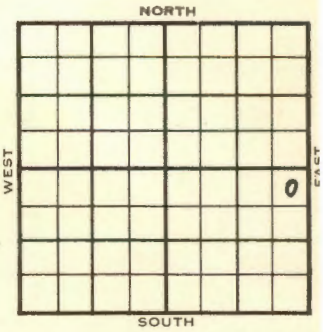

NE NE SE

Sun - DHM Ohio-Acreage

1953	ELEVATION 2697' REPORT
12/16 1954 1/6	MIR Spud 12-15-53 D & A TD 4380 8" @ 194 Heeb 3789 Tor. 3819' Lans. 3832' B KC 4039 Cong. 4224 Arb. 4370' TD 4380' D & A ABANDONED

DX-78

FORM 275 FOR SALE BY KANSAS BLUE PRINT CO.


County Decatur State Kansas

Sec. 7 (Blk. Twp.) 3 (Sur. Rge.) - 29W Map No.

Operator W. W. Sauvage

Well No. 1 Farm Larson

Elev. 2697 Location NE NE SE

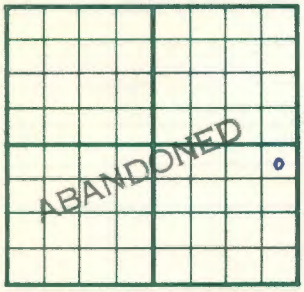

330 Ft. From N Line SE

330 Ft. From E Line Quarter

1st. Report

Completion JAN 8 1954

Remarks Wildcat

Sauvage-Dunn - Contr.

Spudding Date 12-15-53

Drlg. Data D & A TD 4380

8" @ 194 Heeb. 3789 Tor. 3819

Lans. 3832 B KC 4039 Cong. 4224

Arb. 4370 TD 4380

D & A

J. G. McGEHEE

FORM 275 FOR SALE BY KANSAS BLUE PRINT CO.

~~Decatur~~ Correction


County ~~Decatur~~ Decatur State Kansas

Sec. 7 (Blk. Twp.) 3 (Sur. Rge.) 29W Map No.

Operator W. W. Sauvage

Well No. 1 Farm Larson

Elev. Location NE NE SE

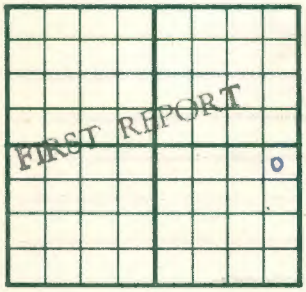

330 Ft. From N Line SE

330 Ft. From E Line Quarter

1st. Report DEC 16 1953

Completion

Remarks ~~Sun - [illegible]~~ Ohio - acreage

Sauvage-Dunn - Contr.

Spudding Date

Drlg. Data Wildcat

M I R

J. G. McGEHEE

FORM 26 200 BKS. 4-52 PETROL

Map No. ____ Sec. 7 Twp. 3 R. 29W


Well No. 1 Larson

W. W. Sauvage Company

CORRECTION Contractor

NE NE SE

SECTION PLAT

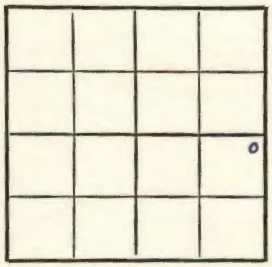

330 Ft. from N. Line

____ Ft. from S. Line

330 Ft. from E. Line

____ Ft. from W. Line

Decatur County

Location ____

Rig up ____

Drilling and Remarks:

Reported
Edwards County

RECORD

Cased ____ in., ____ ft.

Sand ____

Gas ____

Oil ____

Total Depth ____

PRODUCTION

1st 24 hrs. Nat. ____

1st 24 hrs. after shot ____

Gas ____ Cu. Ft.

Dry Hole ____

Abandoned ____

Date

DEC 22 1953 19____

J. G. McGEHEE Scout