


Decatur

KANSAS

SECTION 8 TOWNSHIP 3 RANGE 29W

WELL NO. #1 R. Simpson

COMPANY Sauvage

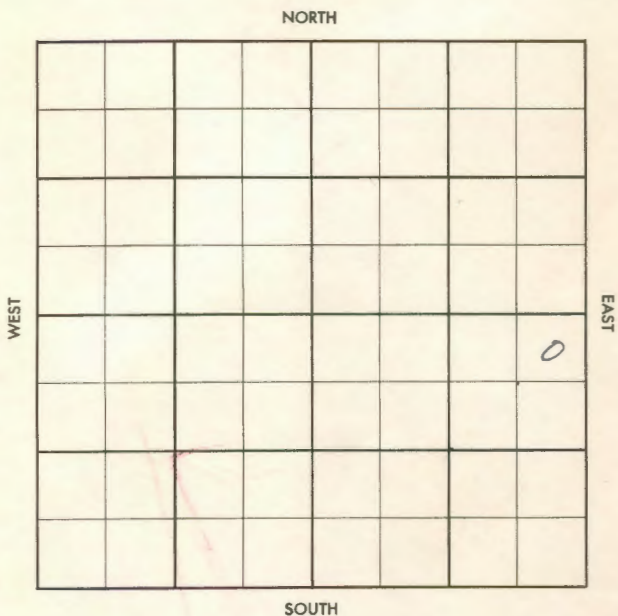

Decatur

KANSAS


SEC. 8 TWP. 3 R. 29W

WELL NO. #1 R. Simpson

COMPANY Sauvage

CONTRACTOR Co. Tools

_____ Ft. from N. Line
 _____ Ft. from S. Line
 _____ Ft. from E. Line
 _____ Ft. from W. Line

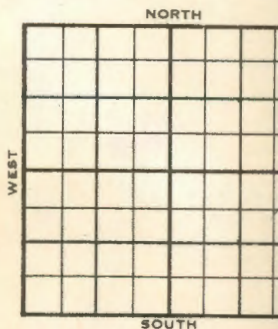

NE NE SE
NE SE NE

1956 ELEVATION REPORT

5-9 MIR
 5-29 8 5/8" @ 200
 2 DST in L - KC
 D & A
 Tp. 3507', H. 3667', Tr. 3696',
 L. 3705', BKC 3894'.
 TD 3923'

ABANDONED

CORRECTION

FORM 513 SUNRAY

County Decatur Elev. 2692
Sec. 8 Twp. 3 Rge. 29W
Company Sauvage
FarmName R. Simpson No. 1

	TOPS	DEPTH	LOG	DATUM	Loc. in Sec.
Anh.					<u>NE NE SE</u> <u>NE SE NE</u>
Tp.		<u>3507</u>			
H.		<u>3667</u>			
Tr.		<u>3696</u>			
Dg.					
Bl.					
L.		<u>3705</u>		<u>1013</u>	<u>Bill Richards</u>
K.C.					Geol.
B.K.C.		<u>3894</u>		<u>1202</u>	Contr.
Ce.					<u>Co. tools</u>
C.					Pool
M.					<u>Pollnow</u>
M.					
K.					
Mz.					
Me.					
V.					
S.					
S.					
A.					
R.					
Pe.					
G.					
T.D.		<u>3923</u>			

ABANDONED
MAY 28 1956

Date Comm. M I R MAY 16 '56 85/8200 MAY 23 '56
MAY 29 '56 (2 DST in L-KC)

D&A (initials)

FORM 513 SUNRAY

County Decatur Elev. _____
Sec. 8 Twp. 3 Rge. 29W
Company Sauvage
FarmName R. Simpson No. 1

	TOPS	DEPTH	LOG	DATUM	Loc. in Sec.
Anh.					<u>NE NE SE</u>
Tp.					
H.					
Tr.					
Dg.					
Bl.					
L.					Geol.
K.C.					Contr.
B.K.C.					<u>Co. tools</u>
Ce.					Pool
C.					<u>Pollnow</u>
M.					
M.					
K.					
Mz.					
Me.					
V.					
S.					
S.					
A.					
R.					
Pe.					
G.					
T.D.					

FIRST REPORT
MAY 9 '56

Date Comm. M I R

MAY 1 1956
D.R.

33